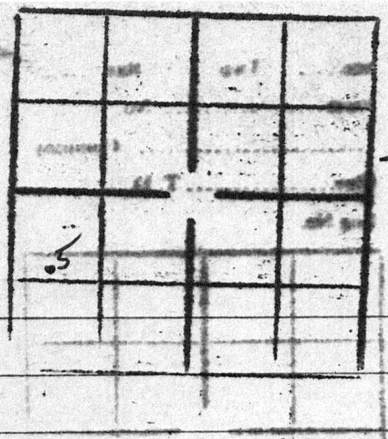


27108

~~#5~~ -

comp - 1-9-23
comp 10-15-23

12" — 475'
10 — 955
8 — 1435
6 — 1677

sur	0-10
sl	15
sh	40
	50
⌐	
sh	90
	100
⌐	
sh	125
⌐	145
sh	180
⌐	200
sh	250
⌐	260
sh	300
⌐	310
sh	320
s	395
sdy	440
⌐	450
sh	465
⌐	480
sh	580
⌐	680
sh	695
⌐	815
s	830
⌐	865
sh	870
⌐	875
sh	895
⌐	910
sh	915
⌐	1000
sh	1005
⌐	1020
sh	1190
⌐	1210
sh	1255
⌐	1260
sh	1270
⌐	1280
sh	1300
⌐	1325
sh	1410
s	1425
sh	1470
⌐	1480
sh	1570
RR	1595
sh	1677
Miss Inf	1677
⌐	1705
Coal	1715
TD	1715