
Form 51 5M 2-22 8411

Map No. K Sec. 21 Twp 23 R. 13

Well No. 5 Jones Farm

R. S. Gillespie Company

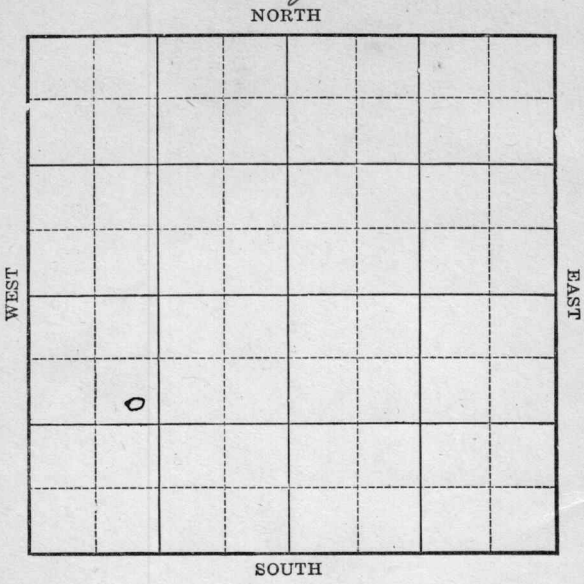

Location

Drilling Remarks:

Rig Up

Drilling Remarks:

RECORD

Cased in. ft.

Sand

Gas

Oil

Total Depth

PRODUCTION

1st 24 hrs. Nat.

1st 24 hrs. after shot

Gas cu. ft.

Dry Hole

Abandoned

Form 252A 5M 4-22 8765

Map No. K Sec. 21 Twp. 23 R. 13

Well No. 5 Jones Farm


R. G. Gillespie Company

990 Ft. from N. Line

_____ Ft. from S. Line

_____ Ft. from E. Line

990 Ft. from W. Line

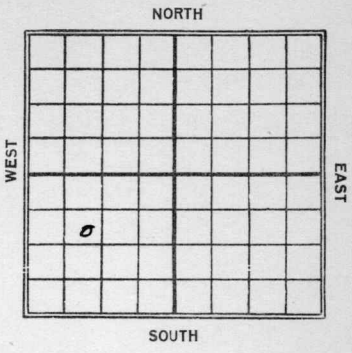

Date 1923	REPORT
9/29	Rig up
11/24	Top Lime 1690'
	Casing 1705-15'
	Shot 40 qts. / 4013 lbs.

Form 26—1M Bks.—3-23—11959.

Map No. KANSAS 17 Sec. 21 Twp. 23 R. 13

Well No. 5 Jones

R G Gillespie Company

Contractor

FIRST REPORT


990 Ft. from N. Line

Ft. from S. Line

Ft. from E. Line

990 Ft. from W. Line

SECTION PLAT

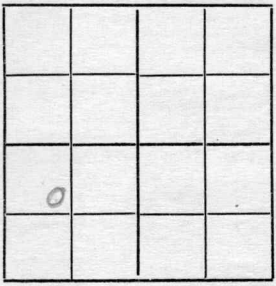

Location

Rig up

Drilling and Remarks:

RECORD

Cased in., ft.

Sand

Gas

Oil

Total Depth

PRODUCTION

1st 24 hrs. Nat.

1st 24 hrs. after shot

Gas Cu. Ft.

Dry Hole

Abandoned

Date

SEP 29 1923

192

M. A. BENEAR

Scout

Form 26—1M Bks.—3-23—11959.

Map No. KANSAS 17 Sec. 21 Twp. 23 R. 13


Well No. 5 Jones

R. St. Gillespie Company

Contractor

COMPLETED

SECTION PLAT

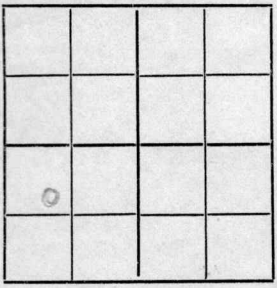

990 Ft. from N. Line

Ft. from S. Line

Ft. from E. Line

990 Ft. from W. Line

Location

Rig up

Drilling and Remarks:

Top Lime 1670

Pay 1705-1715

Shot 40 qts

40 bbls

RECORD

Cased in., ft.

Sand

Gas

Oil

Total Depth

PRODUCTION

1st 24 hrs. Nat.

1st 24 hrs. after shot

Gas Cu. Ft.

Dry Hole

Abandoned

Date

NOV 24 1923

192

M. A. BENEAK Scout