


DX 78-1

Section 4 Township 13 Range .16W

Well No. 1 Madden

Company Rupp- Ferguson

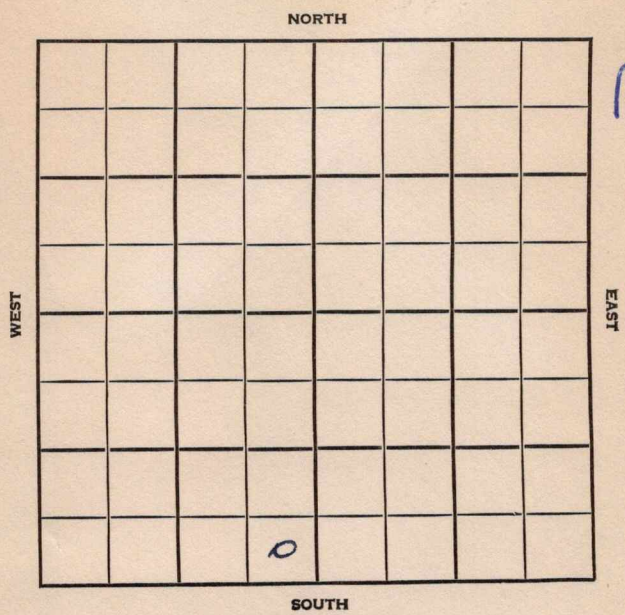

Ellis

KANSAS

SEC.	TWP.	R.
HOT FILE	4	13
		16 W

WELL NO.

1 Madden

FARM

COMPANY

Rupp-Ferguson

CONTRACTOR

Rupp-Ferguson

Emmeran Pool


Ft. from N. Line

330 Ft. from S. Line

330 Ft. from E. Line

Ft. from W. Line

SE SE SW

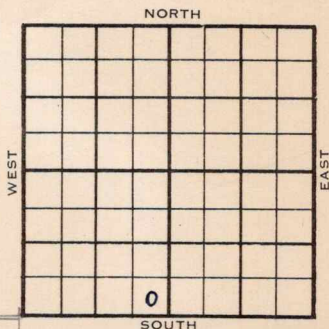

Near MCPC Acreage

1954

ELEVATION

1979'

REPORT

6/9

MICT

6/25

D & A

(Ltr-McGehee

6/23

Spud 6-9-54 - D&A

TD 3503'

8" @ 253'

Heeb 3167', Tor. 3188', Lans 3216'

DST 3235-50', opn 1 hr., rec. 15' SW
340#

B KC 3408', Arb. 3467'

TD 3503'

D&A

ABANDONED

County Ellis State Kansas
 Sec. 4 (Blk. 13) (Sur. 16W) Map No. 13
 Operator Rupp-Ferguson
 Well No. 1 Farm Madden
 Elev. _____ Location SE SE SW

FIRST REPORT

330 Ft. From S Line SW
330 Ft. From E Line Quarter
 1st. Report JUN 9 1954
 Completion _____
 Remarks Near MCPC acreage
Rupp-Ferguson - Contr.
 Spudding Date _____

Drlg. Data

Emmeran PoolMICT

County Ellis State KansasSec. 4 (Blk. Twp.) 13 (Sur. Rge.) 16W Map No.Operator Rupp-FergusonWell No. 1 Farm MaddenElev. 1979 Location SE SE SW330 Ft. From S Line SW330 Ft. From E Line Quarter

1st. Report

Completion JUN 23 1954Remarks Emmeran PoolRupp-Ferguson - Contr.Spudding Date 6-9-54Drlg. Data D & A TD 35038" @ 253 Heeb. 3167 Tor. 3188Lans. 3216 DST 3235-50 open 1 hr.Rec. 15' sw 340# B KC 3408Arb. 3467 TD 3503D & A