


Map No. K17 Sec. 21 Twp. 23 R. 13

Well No. 6 - Jones Farm
R. H. Gillespie Company

NORTH

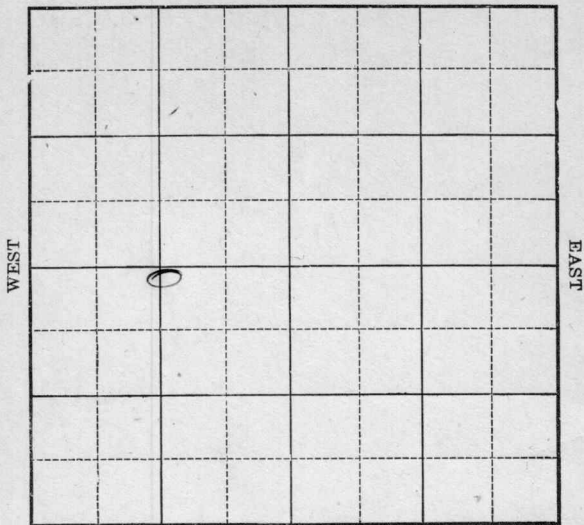

WEST

EAST

SOUTH

Location _____

Drilling Remarks: _____

Rig Up _____

Drilling Remarks: _____

RECORD

Cased _____ in. _____ ft.
Sand _____
Gas _____
Oil _____
Total Depth _____

PRODUCTION

1st 24 hrs. Nat. _____
1st 24 hrs. after shot _____
Gas _____ cu. ft.
Dry Hole _____
Abandoned _____

Map No. **KANSAS** 17 Sec. 21 Twp. 23 R. 13

Well No. *6- Jones*

R. G. Gillespie Company

Contractor

FIRST REPORT

SECTION PLAT

200 Ft. from N. Line

----- Ft. from S. Line

----- Ft. from E. Line

1320 Ft. from W. Line

| | | | |
|--|----------|----------|--|
| | | | |
| | | | |
| | <i>0</i> | <i>9</i> | |
| | | | |

Location -----

Rig up -----

Drilling and Remarks:

Log 1100

RECORD

Cased ----- in., ----- ft.

Sand -----

Gas -----

Oil -----

Total Depth -----

PRODUCTION

1st 24 hrs. Nat. -----

1st 24 hrs. after shot -----

Gas ----- Cu. Ft.

Dry Hole -----

Abandoned -----

Date

NOV 24 1923

M. A. BENEATY

192-----

Scout

Map No. **KANSAS** ¹⁷ Sec. 21 Twp. 23 R. 13

Well No. ^{#6 Jones} _____

R. G. Gillespie Company

_____ Contractor

COMPLETED

SECTION PLAT

200 Ft. from N. Line

_____ Ft. from S. Line

_____ Ft. from E. Line

1320 Ft. from W. Line

| | | | |
|--|---|--|--|
| | | | |
| | | | |
| | 0 | | |
| | | | |

Location _____

Rig up _____

Drilling and Remarks:

*Tap Lineal 1690
pay. 1712-1732'
J.D. 1732
shot 40/70 lbs*

RECORD

Cased _____ in., _____ ft.

Sand _____

Gas _____

Oil _____

Total Depth _____

PRODUCTION

1st 24 hrs. Nat. _____

1st 24 hrs. after shot _____

Gas _____ Cu. Ft.

Dry Hole _____

Abandoned _____

Date

JAN 18 1924

M. A. BENEAR

192

Scout