


Section 17 Township 27 Range 6 E

Well No. # 2 McLean

Company H & M Drlg.

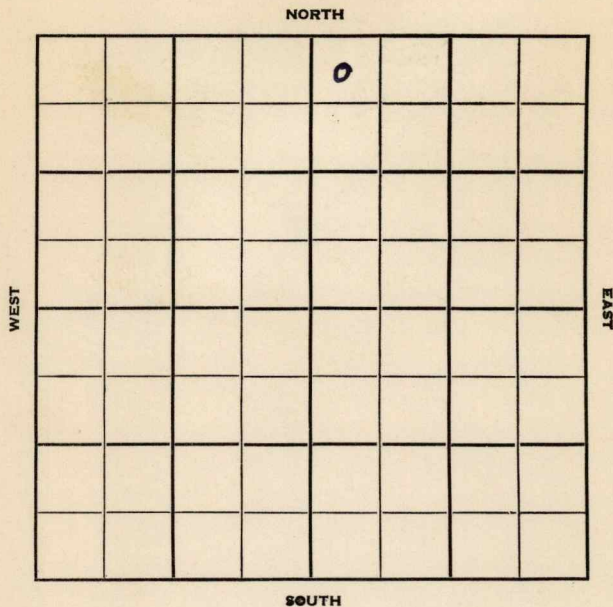

Butler

KANSAS

Sec. 17 Twp. 27 R. 6E

Well No. #2 McLean Farm

H & M Drlg. Company

Contractor


330 Ft. from N. Line

Ft. from S. Line

Ft. from E. Line

330 Ft. from W. Line

NW NW NE

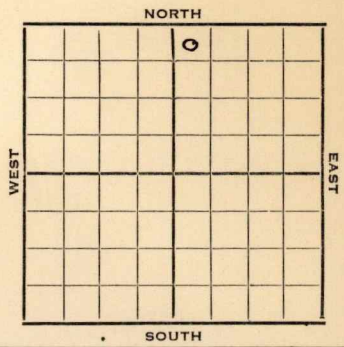

1952 Elev. 1388'

REPORT

5/28 Spud 5-21-52
8" @ 55'

Lans. 1820 KC 2130
Drlg. 2545'

6/25 Spud 5-21-52
Oil Well TD 2758
8" @ 55

Lans. 1820 KC 2130
Bart 2700 Cherty Sd 2718 7" @ 2718
Miss 2755-58 TD 2758
Comp. 15 bopd

COMPLETED

County **Butler** State **Kansas**

Sec. **17** (Blk. Twp.) **27** (Sur. Rge.) **6E** Map No.

Operator **H & M Drlg.**

Well No. **2** Farm **McLean**

Elev. **1388** Location **NW NW NE**

FIRST REPORT

330 Ft. From **N** Line **NE**

330 Ft. From **W** Line Quarter

1st. Report **MAY 28 1952**

Completion

Remarks

Spudding Date **5-21-52**

Drlg. Data

8" @ 55 Lens 1820 KC 2130 Drlg. 2545

J. G. McGEHEE

