


20175

27103

#6-

Comm - 10-30-23  
conf 11-23-23

21	23S	13E
D. J. B.		
Gillespie		
T. B.		
Lot No.		

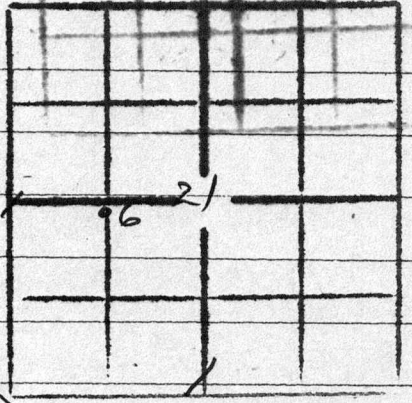

- sail 0-2
- sh 15
- L 25
- sh 75
- L 130
- sh 330
- withs 460
- sh 615
- L 880
- RR 910
- L 920
- sh 930
- L 1000
- sh 1008
- L 1050
- sh 1190
- L 1240
- sh 1275
- L 1300
- sh 1420
- S 1440
- L 1450
- sh 1690
- mess 1696
- sh oil @ 1696
- sdL 1712
- alts 17325

*over*