


Map No. K17 Sec. 21 Twp. 23 R. 13

Well No. 7 Jones Farm  
R. H. Gillespie Company

NORTH

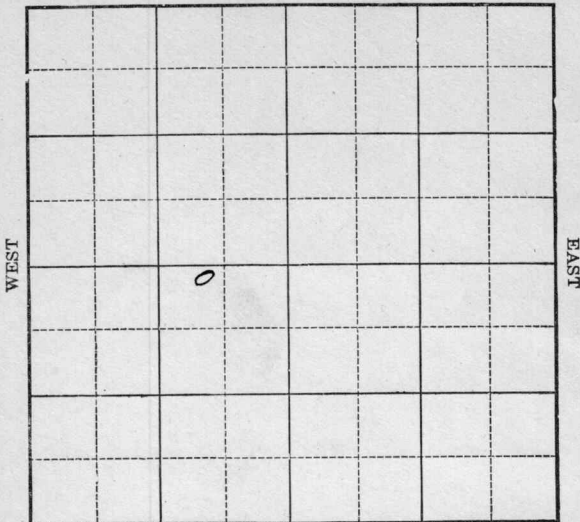

Location \_\_\_\_\_

Rig Up \_\_\_\_\_

Drilling Remarks:

Drilling Remarks:

\_\_\_\_\_

\_\_\_\_\_

RECORD

PRODUCTION

Cased \_\_\_\_\_ in. \_\_\_\_\_ ft.

Sand \_\_\_\_\_

Gas \_\_\_\_\_

Oil \_\_\_\_\_

Total Depth \_\_\_\_\_

1st 24 hrs. Nat. \_\_\_\_\_

1st 24 hrs. after shot \_\_\_\_\_

Gas \_\_\_\_\_ cu. ft.

Dry Hole \_\_\_\_\_

Abandoned \_\_\_\_\_

Map No. K Sec. 21 Twp. 23 R. 13


Well No. 7 Jones Farm  
P. G. Gillespie Company

200 Ft. from N. Line

\_\_\_\_\_ Ft. from S. Line

760 Ft. from E. Line

\_\_\_\_\_ Ft. from W. Line

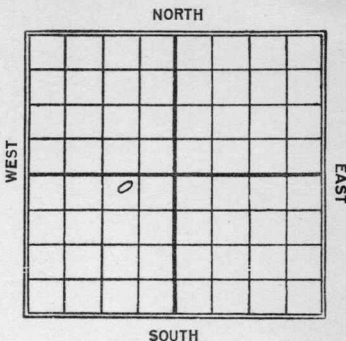

Date	REPORT
11/24	Rig
12/19	1200
1924	
1/18	Top Line 1724
	Pay 1747-1764
	Jul 1964
	shot 40/20 Bits

Map No. **KANSAS** 17 Sec. 21 Twp. 23 R. 13

Well No. 7 James

R. G. Gillespie Company

Contractor

**FIRST REPORT**

**SECTION PLAT**

200 Ft. from N. Line

Ft. from S. Line

760 Ft. from E. Line

Ft. from W. Line

	o		

Location -----

Rig up -----

Drilling and Remarks:

Rig

**RECORD**

Cased \_\_\_\_\_ in., \_\_\_\_\_ ft.

Sand -----

Gas -----

Oil -----

Total Depth -----

**PRODUCTION**

1st 24 hrs. Nat. -----

1st 24 hrs. after shot -----

Gas ----- Cu. Ft.

Dry Hole -----

Abandoned -----

Date

NOV 24 1923

M. A. BENEAR

192

Scout

Map No. **KANSAS** <sup>17</sup> Sec. 21 Twp. 23 R. 13

Well No. #7 Jones

R. G. Gillespie Company

Contractor

**NOT COMPLETED**

**SECTION PLAT**

200 Ft. from N. Line

\_\_\_\_\_ Ft. from S. Line

760 Ft. from E. Line

\_\_\_\_\_ Ft. from W. Line

	o		

**COMPLETED**

Location \_\_\_\_\_

Rig up \_\_\_\_\_

Drilling and Remarks:

*Tap Line 1724*  
*Pay 1747-1764*  
*J.D. 1764*  
*40/20 bbl*

**RECORD**

Cased \_\_\_\_\_ in., \_\_\_\_\_ ft.

Sand \_\_\_\_\_

Gas \_\_\_\_\_

Oil \_\_\_\_\_

Total Depth \_\_\_\_\_

**PRODUCTION**

1st 24 hrs. Nat. \_\_\_\_\_

1st 24 hrs. after shot \_\_\_\_\_

Gas \_\_\_\_\_ Cu. Ft.

Dry Hole \_\_\_\_\_

Abandoned \_\_\_\_\_

Date

**M. A. BENEAR**

JAN 18 1924

Scout