
Sec. 21 Twp. 23S Rge. 13E
Farm D. Jones No.
Gillespie Company
Elev. T. D.
Log No.

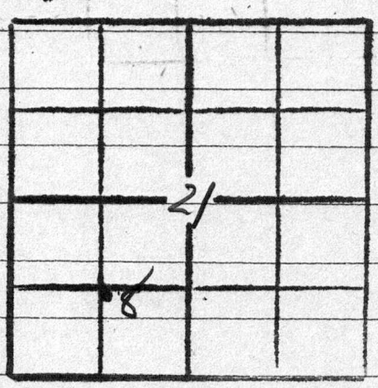

#8 - 27101

comm -
conf - 2-25-24

12" - 435
10 - 975
8 - 1440
6 - 1683

sil	0-5
sh	30
⌐	40
sh	85
⌐	105
sh	120
⌐	130
sh	150
⌐	160
sh	230
⌐	245
sh	330
S	430
sh	530
⌐	535
sh	605
⌐	650
sh	660
⌐	715
sh	750
⌐	845
sh	860
⌐	890
RR	912
⌐	1000
sh	1010
⌐	1060
sh	1110
S	1130
sh	1200
⌐	1212
sh	1303
⌐	1320
sh	1422
≤	1440
sh	1683
⌐	1713
oils	1723 TD