


Section 17 Township 27 Range 6-E

Well No. #1 Pickrell

Company Thrifty Drig  
Miscellaneous

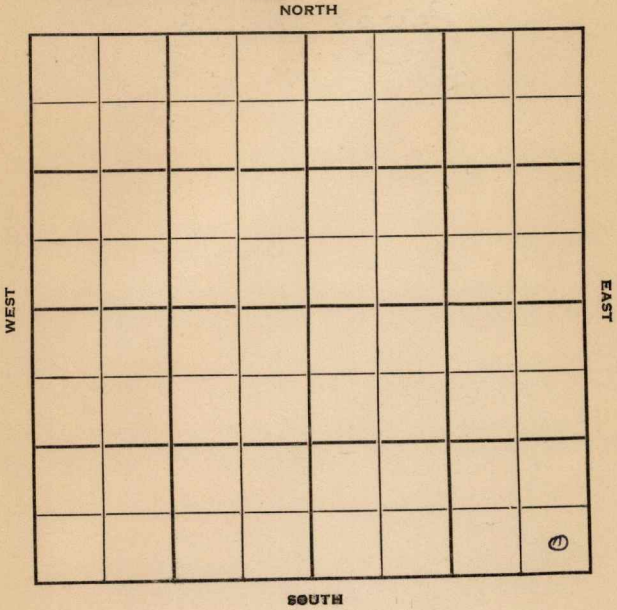

Sec. 17 Twp. 27 R. 6E

Well No. #1 Pickrell Farm

Thrifty Drlg. Company

Thrifty Drlg. Contractor

Miscellaneous


\_\_\_\_\_ Ft. from N. Line

330' Ft. from S. Line

330' Ft. from E. Line

\_\_\_\_\_ Ft. from W. Line

SE/c

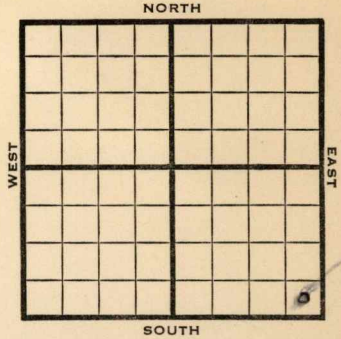

1949 **Elev 1356'** REPORT

- 10/26 8" @ 120'  
**KC 2100'**  
**Miss 2718'**  
TD 3030'  
5" @ 3030'
- 11/1       "
- 11/9 **Viola 3099'**  
TD 3100'  
PB 2770'  
22 shots 2747-55'
- 11/16 TD 3100'  
**Viola 3099'**  
Aband.

**ABANDONED**

Map No. \_\_\_\_\_ Sec. 17 Twp. 27 R. 6E

Well No. 1 Pickrell

Thrifty Drlg. Company

Thrifty Drlg. Contractor

SE/C

FIRST REPORT  
SECTION PLAT

\_\_\_\_\_ Ft. from N. Line

330 Ft. from S. Line

330 Ft. from E. Line

\_\_\_\_\_ Ft. from W. Line


Butler County

Location \_\_\_\_\_

Rig up \_\_\_\_\_

Drilling and Remarks:

8" @ 120

KC 2100

Miss. 2718

TD 3030

5" @ 3030

RECORD

Cased \_\_\_\_\_ in., \_\_\_\_\_ ft.

Sand \_\_\_\_\_

Gas \_\_\_\_\_

Oil \_\_\_\_\_

Total Depth \_\_\_\_\_

PRODUCTION

1st 24 hrs. Nat. \_\_\_\_\_

1st 24 hrs. after shot \_\_\_\_\_

Gas \_\_\_\_\_ Cu. Ft.

Dry Hole \_\_\_\_\_

Abandoned \_\_\_\_\_

Date

OCT 26 1949

19

S. J. LEWIS Scout

Map No. \_\_\_\_\_ Sec. 17 Twp. 27 R. 6E

Well No. 1 Pickrell

Thrifty Drlg. Company

ABANDONED Contractor

SE/C

*E1, 1356*  
SECTION PLAT

\_\_\_\_\_ Ft. from N. Line

330 Ft. from S. Line

330 Ft. from E. Line

\_\_\_\_\_ Ft. from W. Line


Butler County

Location \_\_\_\_\_

Rig up \_\_\_\_\_

Drilling and Remarks:

*W-3098*

RECORD

Cased \_\_\_\_\_ in., \_\_\_\_\_ ft.

Sand \_\_\_\_\_

Gas \_\_\_\_\_

Oil \_\_\_\_\_

Total Depth 3100

PRODUCTION

1st 24 hrs. Nat. \_\_\_\_\_

1st 24 hrs. after shot \_\_\_\_\_

Gas \_\_\_\_\_ Cu. Ft.

Dry Hole \_\_\_\_\_

Abandoned \_\_\_\_\_

Date

NOV 16 1949

19

S. J. LEWIS

Scout