FORM 51 5M PETROL


KANSAS

Greenwood

Section 32 Township 23 Range 13E

Well No. #1 F. Berry

Company Rockhill Sand & Gravel

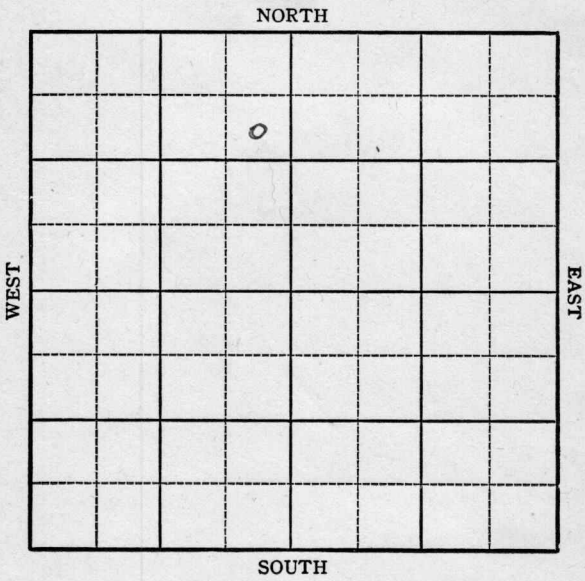

FORM 252-A
5M 9-43 GASS KANSAS

Greenwood

Sec. 32 Twp. 23 R. 13E

Well No. #1 F. Berry Farm

Rockhill Sand & Gravel Company

Miscellaneous


990 Ft. from N. Line

Ft. from S. Line

330 Ft. from E. Line

Ft. from W. Line

SE NE NW

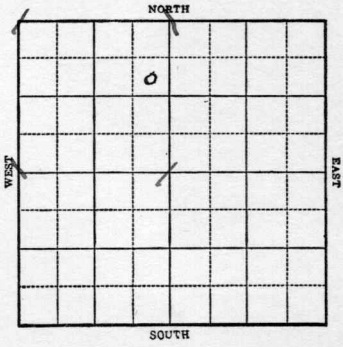

1944	REPORT
2/9	Drlg. 735
2/15	Drlg. 1351 10" @ 880
2/23	Miss 1640 TD 1675'
	ABANDONED.

Form 26 200 Bks 5-42 Petrol Greenwood

KANSAS

Map No. 17 Sec. 32 Twp. 23 R. 13E

Well No. 1 F. Berry

Rockhill Sand & Gravel Company

FIRST REPORT Contractor

SE NE NW


990 Ft. from N. Line

Ft. from S. Line

330 Ft. from E. Line

Ft. from W. Line

SECTION PLAT

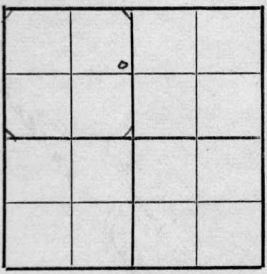

Miscellaneous

Location

Rig up

Drilling and Remarks:

Drlg. 735

RECORD

Cased in., ft.

Sand

Gas

Oil

Total Depth

PRODUCTION

1st 24 hrs. Nat.

1st 24 hrs. after shot

Gas Cu. Ft.

Dry Hole

Abandoned

Date

FEB 9 1944 19

S. J. LEWIS Scout

Form 26 200 Bks 5-42 Petrol

Greenwood

KANSAS

Map No. 7 Sec. 32 Twp. 23 R. 13E

Well No. 1 F. Berry

Rockhill Sand & Gravel Company

ABANDONED Contractor

SE NE NW


990 Ft. from N. Line

Ft. from S. Line

330 Ft. from E. Line

Ft. from W. Line

SECTION PLAT

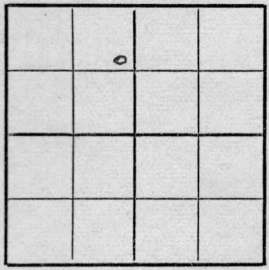

Miscellaneous

Location

Rig up

Drilling and Remarks:

Miss 1640

RECORD

Cased in., ft.

Sand

Gas

Oil

Total Depth 1675

PRODUCTION

1st 24 hrs. Nat.

1st 24 hrs. after shot

Gas Cu. Ft.

Dry Hole

Abandoned

Date

FEB 2 3 1944 19

S. J. LEWIS Scout