
Form 51 5M 2-22 8411

Map No. _____ Sec. 32 Twp. 23 R. 13

Well No. 2 Dehlinger Farm

Rogers Company

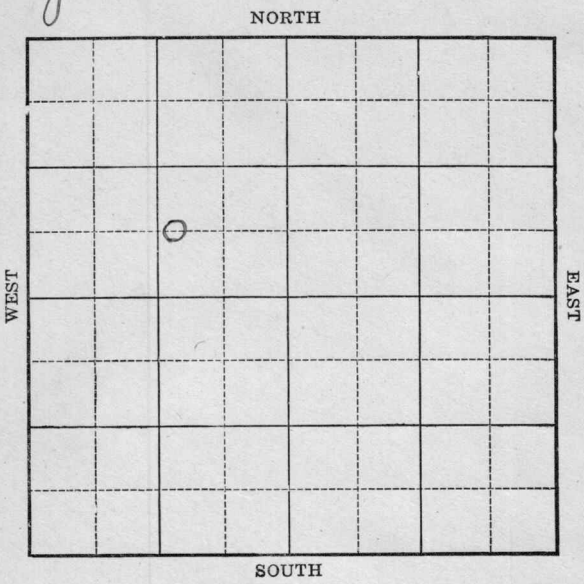

Location _____

Drilling Remarks:

Rig Up _____

Drilling Remarks:

RECORD

Cased _____ in. _____ ft.

Sand _____

Gas _____

Oil _____

Total Depth _____

PRODUCTION

1st 24 hrs. Nat. _____

1st 24 hrs. after shot _____

Gas _____ cu. ft.

Dry Hole _____

Abandoned _____

Form 252A 5M 8-21 PALACE-TULSA 6835

Map No. _____ Sec. 32 Twp. 23 R. 13

Well No. 2 Dehlinger Farm


Rogers Company

_____ Ft. from N, Line

660 Ft. from S. Line

1120 Ft. from E. Line

_____ Ft. from W. Line

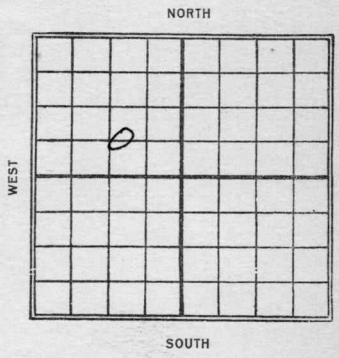

Date 1923	REPORT
1/26	Spud.
3/2	D.+A. 1712'

Form 26—1M—4-19—Mid-West

Map No. [redacted] Sec. 32 Twp. 23 R. 13

Well No. 2 Wichlinger

Rogers Company

Mat Hookey Contractor

FIRST REPORT


_____Ft. from N. Line

660 Ft. from S. Line

1130 Ft. from E. Line

_____Ft. from W. Line

SECTION PLAT

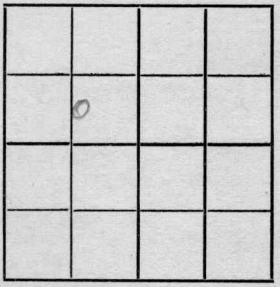

Location _____

Rig up _____

Drilling and Remarks:

spud

RECORD

Cased _____in., _____ft.

Sand _____

Gas _____

Oil _____

Total Depth _____

PRODUCTION

1st 24 hrs. Nat. _____

1st 24 hrs. after shot _____

Gas _____Cu. Ft.

Dry Hole _____

Abandoned _____

Date JAN 26 1923

_____191____. M. A. BENEAR Scout

Form 26—1M—4-19—Mid-West

Map No. KANSAS 17 Sec. 32 Twp. 23 R. 13


Well No. 2 Loehlinger

Lagoon etal Company

Contractor

ABANDONED

SECTION PLAT

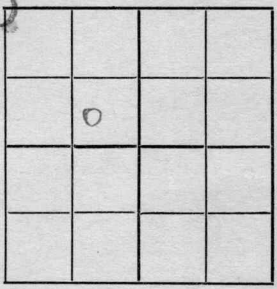

660 Ft. from N. Line

660 Ft. from S. Line

1120 Ft. from E. Line

Ft. from W. Line

Location

Rig up

Drilling and Remarks:

Lot 9
1712

RECORD

Cased in., ft.

Sand

Gas

Oil

Total Depth

PRODUCTION

1st 24 hrs. Nat.

1st 24 hrs. after shot

Gas Cu. Ft.

Dry Hole

Abandoned

Date

MAR 2 1923 191

M. A. BENEAR Scout