

Butler **KANSAS**

Section 18 Township 27 Range 6 E

Well No. # 1 Siglem

Company H. T. Weideman

NORTH

							0

WEST

EAST

SOUTH

Sec. 18 Twp. 27 R. 6E

Well No. #1 Siglem Farm

K.T. Weideman Company

Contractor

Ft. from N. Line

330


Ft. from S. Line

330

Ft. from E. Line

Ft. from W. Line

SE SE SE

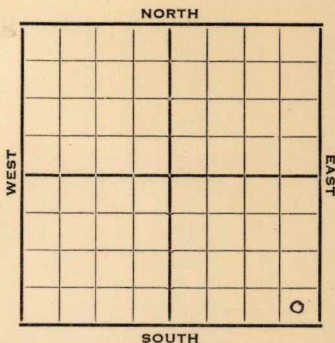

1952

Elev. 1389'

REPORT

6/11

Spud 6-9-52

6/18

Spud 6-9-52

D & A TD 2850' 8" @ 96 KC 2162'

B KC 2367' Sd & shale 2734'

Sand 2784' Miss 2823'

TD 2850' D & A

**ABANDONED**




County Butler State Kansas

Sec. 18 (Blk. 27 Twp.) (Sur. 6E Rge.) Map No.

Operator K. T. Weidemann

Well No. 1 Farm Siglem

Elev. 1389 Location SE SE SE

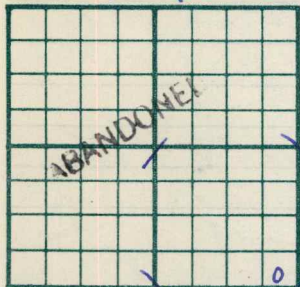

330 Ft. From S Line SE

330 Ft. From E Line Quarter

1st. Report

Completion JUN 1 8 1952

Remarks

Spudding Date 6-9-52

Drlg. Data D & A TD 2850

8" @ 96 KC 2162 B KC 2367

Sd. & shale 2734 Sand 2784 Miss. 2823

TD 2850

D & A

J. G. McGEHEE