


Kansas

Map No. _____ Sec. 19 Twp. 27 R. 6Well No. 1 Bollner Farm _____Empire Gas & Coal Company _____

NORTH

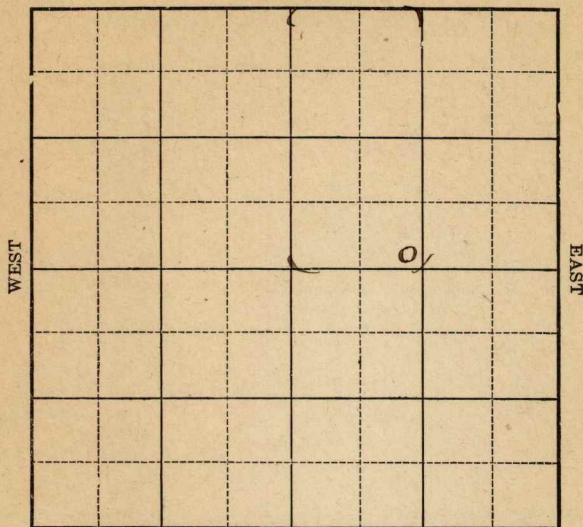

SOUTH

Location _____

Drilling Remarks:

Rig Up _____

Drilling Remarks:

RECORD

Cased _____ in. _____ ft.

Sand _____

Gas _____

Oil _____

Total Depth _____

PRODUCTION

1st 24 hrs. Nat. _____

1st 24 hrs. after shot _____

Gas _____ cu. ft.

Dry Hole _____

Abandoned _____

Map No. _____ Sec. 19 Twp. 27 R. 6

Well No. #1 Beollner Farm _____
Empire Gas & Fuel Company

NORTH


_____ Ft. from N. Line

200 Ft. from S. Line

_____ Ft. from E. Line

1120 Ft. from W. Line

WEST

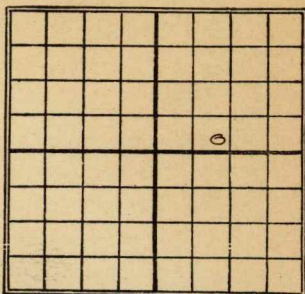

EAST

SOUTH

Date

REPORT

1922

5/21

Rgn up

7/22

2691-2725

Shot 40 gts 500 lbs

Map No. 19 Sec. 27 Twp. 6 R. 6
 Well No. 1 Beallner
Empire Gas & Fuel Company
 Contractor

FIRST REPORT

SECTION PLAT

_____ Ft. from N. Line
200 Ft. from S. Line
 _____ Ft. from E. Line
1120 Ft. from W. Line

Location _____
 Rig up _____
 Drilling and Remarks:

Location
Rig up

RECORD

Cased _____ in., _____ ft.
 Sand _____
 Gas _____
 Oil _____
 Total Depth _____

PRODUCTION

1st 24 hrs. Nat. _____
 1st 24 hrs. after shot _____
 Gas _____ Cu. Ft.
 Dry Hole _____
 Abandoned _____

Date

MAY 21 1922

M. A. BENEAR

191

Scout

Map No. Range 11 Sec. 19 Twp. 27 R. 6Well No. 1 Bollner
Empire Gas & Fuel Company

Contractor

COMPLETED

SECTION PLAT

Ft. from N. Line

200

Ft. from S. Line

Ft. from E. Line

1120

Ft. from W. Line

Location

Rig up

Drilling and Remarks:

shot 40 gts

RECORD

Cased _____ in., _____ ft

Sand _____

Gas _____

Oil 2691-2725Total Depth 2725

PRODUCTION

1st 24 hrs. Nat. _____

1st 24 hrs. after shot 501

Gas _____ Cu. Ft

Dry Hole _____

Abandoned _____

Date

JUL 22 1900

M. A. BENEAR

191

Scour