


Section 32 Township 23 Range 13E

Well No. #1 Gordon

Company Wandra Oil

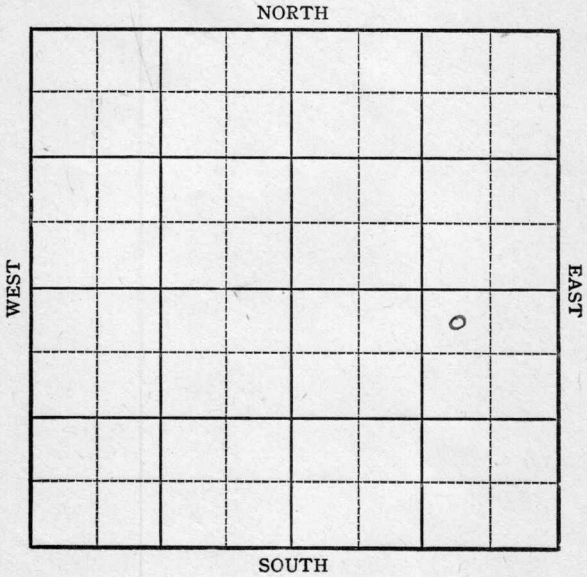

KANSAS

Greenwood

Sec. 32 Twp. 23 R. 13E

Well No. #1 Gordon Farm

Wandra Company

Miscellaneous


330 Ft. from N. Line

_____ Ft. from S. Line

990 Ft. from E. Line

_____ Ft. from W. Line

NW NE SE

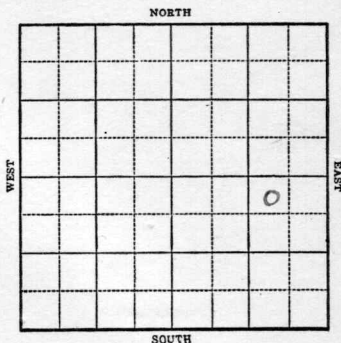

R E P O R T

1944

2/2	Location
2-9	"
2-16	Spud
2/23	12@ 22' Drlg. 555
3/1	Drlg. 110
3/7	SD
3/15	6" @ 802 Drlg. 985
3/22	1230 S _a for 5"
3/29	5" @ 1200 Drlg. 1350'
4/5	Miss 1613-15 TD 1400' oil in 48 hrs.
4/12	5" @ 1220 fsg.
4/19	" " "
4/26	Drilling 1525
5/3	SD
5/10	"
5/17	SD 1625

OVER

1944

5/24 5" @ 1612
TD 1615
WOC

5/31 "

6/7 5" @ 1612
Miss. 1607
TD 1615
2000 acid
Pump 100 Pot.
Grav. 36.4

COMPLETED

KANSAS

Map No. 17 Sec. 32 Twp. 23 R. 13E

Well No. 1 Gordon

Wandra Oil Company

FIRST REPORT Contractor

NW NE SE

SECTION PLAT

330 Ft. from N. Line

_____ Ft. from S. Line

990 Ft. from E. Line

_____ Ft. from W. Line

			0

Miscellaneous

Location X

Rig up _____

Drilling and Remarks:

RECORD

Cased _____ in., _____ ft.

Sand _____

Gas _____

Oil _____

Total Depth _____

PRODUCTION

1st 24 hrs. Nat. _____

1st 24 hrs. after shot _____

Gas _____ Cu. Ft.

Dry Hole _____

Abandoned _____

Date

FEB 2 1944 19

S. J. LEWIS Scout

KAN

Map No. 17 Sec. 32 Twp. 23 R. 13E

Well No. 1 Gordon

Wandra Company

FIRST REPORT Contractor

NW NE SE

SECTION PLAT

330 Ft. from N. Line

_____ Ft. from S. Line

990 Ft. from E. Line

_____ Ft. from W. Line

<i>Duplicate</i>			
			o

Miscellaneous

Location X

Rig up _____

Drilling and Remarks:

RECORD

Cased _____ in., _____ ft.

Sand _____

Gas _____

Oil _____

Total Depth _____

PRODUCTION

1st 24 hrs. Nat. _____

1st 24 hrs. after shot _____

Gas _____ Cu. Ft.

Dry Hole _____

Abandoned _____

Date

FEB 9 1944 19

S. J. LEWIS Scout

KANSAS

Pool Name Miscellaneous

Map No. 17 Sec. 32 Twp. 23 R. 13E

Well No. 1 Gordon

Wandra Oil Company

COMPLETED

Contractor

NW NE SE

SECTION PLAT

330 Ft. from N. Line

_____ Ft. from S. Line

990 Ft. from E. Line

_____ Ft. from W. Line

			Δ

Greenwood County

Location _____

Rig up _____

Drilling and Remarks:

*Miss 1607
5" C 1612.
2000 acid
Pump 100 P.D*

36 4/8

RECORD

Cased _____ in., _____ ft.

Sand _____

Gas _____

Oil _____

Total Depth 1615

PRODUCTION

1st 24 hrs. Nat. _____

1st 24 hrs. after shot _____

Gas _____ Cu. Ft.

Dry Hole _____

Abandoned _____

Date

JUN 7 1944 19

S. J. LEWIS Scout