

Map No. _____ Sec. 19 Twp. 27 R. 6
Well No. 5 Boellner Farm _____
Hayt Etal Company _____

NORTH

WEST

EAST

SOUTH

Location _____

Drilling Remarks:

Rig up

Drilling Remarks:

RECORD

Cased _____ in. _____ ft.

Sand _____

Gas _____

Oil _____

Total Depth_____

PRODUCTION

1st 24 hrs Nat.

1st 24 hrs. after shot

Gas _____ cu. ft.

Dry Hole _____


Abandoned _____

Map No. _____ Sec. 19 Twp. 27 R. 6Well No. 5 Boellner Farm
Hoyt Etal Company1320 Ft. from N. Line

_____ Ft. from S. Line

1120 Ft. from E. Line

_____ Ft. from W. Line

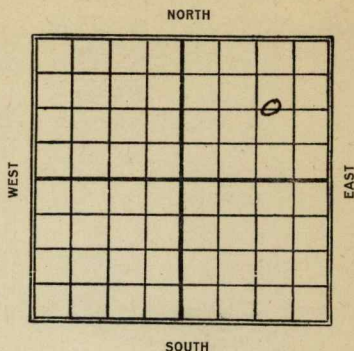

Date

REPORT

1923

1/6 Deq. 800'
6/23 Sand 2722-37- Shot
40 gts. 25 BBs.

Map No. **KANSAS** ¹¹ Sec. **19** Twp. **27** R. **6**

Well No. **3 Baellner**

Haystack Company

Contractor

FIRST REPORT

SECTION PLAT

1320 Ft. from N. Line

_____ Ft. from S. Line

1120 Ft. from E. Line

_____ Ft. from W. Line

			0

Location _____

Rig up _____

Drilling and Remarks:

20 yd. Pool

RECORD

Cased _____ in., _____ ft.

Sand _____

Gas _____

Oil _____

Total Depth _____

PRODUCTION

1st 24 hrs. Nat. _____

1st 24 hrs. after shot _____

Gas _____ Cu. Ft.

Dry Hole _____

Abandoned _____

Date

JAN 6 1923

191

M. A. BENEAR

Scout

Map No. **KANSAS** 11 Sec. 19 Twp. 27 R. 6Well No. 5 *Bealmer**Hayketal* Company

Contractor

COMPLETED SECTION PLAT1320 Ft. from N. Line

_____ Ft. from S. Line

1120 Ft. from E. Line

_____ Ft. from W. Line

			0

Location _____

Rig up _____

Drilling and Remarks:

sand { 2722
273740/25 *46***RECORD**

Cased _____ in., _____ ft.

Sand _____

Gas _____

Oil _____

Total Depth _____

PRODUCTION

1st 24 hrs. Nat. _____

1st 24 hrs. after shot _____

Gas _____ Cu. Ft.

Dry Hole _____

Abandoned _____

Date

M. A. BENEARJUN 23 1923

Scout