


Section 6 Township 13 Range 16W

Well No. #1 Windholz

Company Victor Drlg. (Deep Rock 1/4 Int.)

NORTH

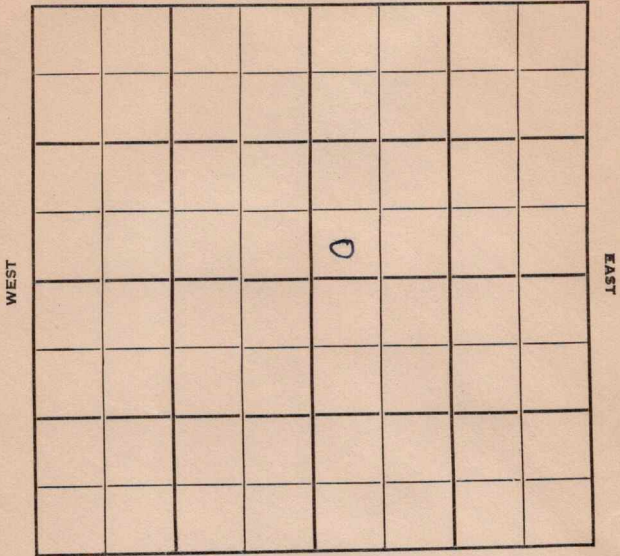

7

WEST

EAST

SOUTH

Sec. 6 Twp. 13 R. 16W

Well No. #1 Windholz Farm

Victor Drlg. (Deep Rock 1/4 Int.) Company

Wildcat Contractor

Ft. from N. Line

330


Ft. from S. Line

Ft. from E. Line

330

Ft. from W. Line

SW SW NE

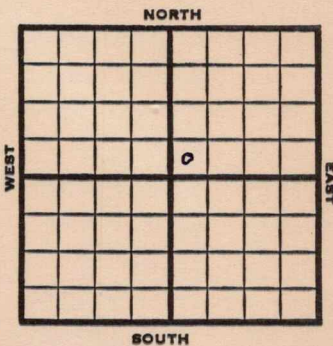

Lion & Amerada support

Elev. 2026'

REPORT

1952

- 10/1 8" @ 197
- 10/8 Drlg. 3025'
- 10/15 Heeb. 3215 Lans. 3265
DST 3272-300, 1 hr. 1800' gassy oil
Arb. 3523
- 10/22 TD 3570' 5" @ 3568'
CO 3570 27/ 3520-30 S/ 2 BOPH
500 A S/ 8 BOPH POP
- 10/29 NR
- 11/6 P/ 14 BO & 25 BWPD
- 11/12 P/ 27 BO & 100 Bwph
- 11/20 P/30 BO & 100 BWPD
- 11/26 NR
- 12/4 PB 3300 20/3291-96 4 BOPH
- 12/11 500A S/10 BOPH POP
- 12/17 Oil Well
TD 3570'
8" @ 197
Heeb 3215, Lans 3265,
DST 3272-3300, opn 1 hr., rec.
1800' gassy oil 1000#
Arb 3523
DST 3526-37, opn 1 hr., rec. 60'
socm, 280' ocm, 20% oil, 30' w
780#
TD 3570
5" @ 3568

OVER

739955

(Information Brought Forward)

1952

12/17 CO to 3570 27/3520-30
 S/2 boph 500A
 S/8 boph
 P/14 bo 25 bwph
 P/27 bo 100 bwpd
 P/14 bo 25 bwpd
 P/30 bo 100 bwpd
 PB 3480 20/3291-96 4 bopd 500A
 S/10 boph
 Comp. 599 bopd

COMPLETED

