

Well No. 2 Snodgrass Farm
Derby Company

WEST

EAST

SOUTH

Rig Up _____

Drilling Remarks:

PRODUCTION

1st 24 hrs. Nat. _____

1st 24 hrs. after shot

Gas _____ cu. ft.

Dry Hole _____

Total Depth_____


Abandoned _____

Map No. _____ Sec. 19 Twp. 27 R. 6Well No. 2 Snodgrass Farm _____
Derby Company _____200 Ft. from N. Line

_____ Ft. from S. Line

1120 Ft. from E. Line

_____ Ft. from W. Line

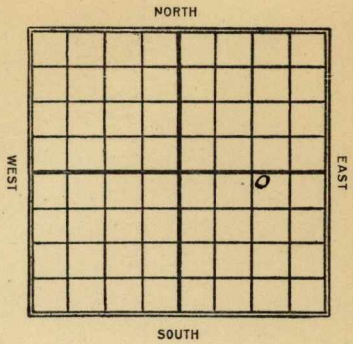

Date

REPORT

3/12

Timbers

3/30

Rig

5/21

Dry Id 2677-82'

Slate 2682-90'

Oil sand 2690-2712

Swabbed 180 bbls Nat

Shot 40 gts 200 bbls

Map No. K11 Sec. 19 Twp. 27 R. 6Well No. 2 snodgrassL. Derby Company

Contractor

FIRST REPORT

SECTION PLAT

200' Ft. from N. Line

Ft. from S. Line

1120' Ft. from E. Line

Ft. from W. Line

			0

Location

Rig up

Drilling and Remarks:

timbers

RECORD

Cased _____ in., _____ ft.

Sand _____

Gas _____

Oil _____

Total Depth _____

PRODUCTION

1st 24 hrs. Nat. _____

1st 24 hrs. after shot _____

Gas _____ Cu. Ft.

Dry Hole _____

Abandoned _____

Date

MAR 12 1922

191

M. A. BENEAR

Scout

11 Kane.
 Map No. _____ Sec. 19 Twp. 27 R. 6
 Well No. 2 Smudgrass
Herby _____ Company
 _____ Contractor

COMPLETED SECTION PLAT

200 Ft. from N. Line

_____ Ft. from S. Line

1120 Ft. from E. Line

_____ Ft. from W. Line

			0

Location _____

Rig up _____

Drilling and Remarks:

Dry sand 2677-82'
 slate 2682-90'

oil sand 2690-2712

swapped 180 lbs

Nat.

shot 40 gals.

200 lbs.

RECORD

Cased _____ in., _____ ft.

Sand _____

Gas _____

Oil _____

Total Depth 2715

PRODUCTION

1st 24 hrs. Nat. _____

1st 24 hrs. after shot _____

Gas _____ Cu. Ft.

Dry Hole _____

Abandoned _____

Date

MAY 21 1922

191

M. A. BENEAR

Scout