

KANSAS

Ellis

Section 11 Township 13 Range 16-W

Well No. #1 Riedel

Company Jackson & Lindsley

NORTH

WEST

EAST

|  |  |  |   |  |  |  |  |
|--|--|--|---|--|--|--|--|
|  |  |  |   |  |  |  |  |
|  |  |  |   |  |  |  |  |
|  |  |  |   |  |  |  |  |
|  |  |  |   |  |  |  |  |
|  |  |  | 0 |  |  |  |  |
|  |  |  |   |  |  |  |  |
|  |  |  |   |  |  |  |  |
|  |  |  |   |  |  |  |  |

SOUTH

Ellis

KANSAS

Sec. 11 Twp. 13 R. 16W ✓

Well No. #1 Riedel Farm

Jackson & Lindsley Company

Contractor

Wildcat


330' Ft. from N. Line

Ft. from S. Line

330' Ft. from E. Line

Ft. from W. Line

NE NE SW

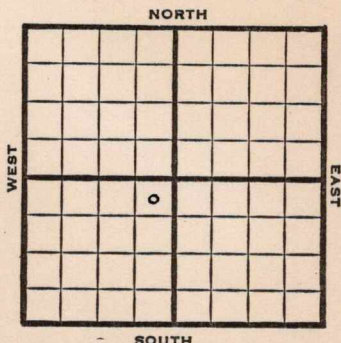

1950

Elev. 1955' REPORT

11/15

Location

12/6

D&A TD 3466

8" @ 130

Anhy 1065' Top 2904

Stain 3087-99 Heeb 3121

Dodge 3138' Lans. 3172


Stain 3200-02

DST 3075-3265 opn 75 min

Rec. 75' mud BHP 750#

Arb. 3436 TD 3466 D&A

ABANDONED

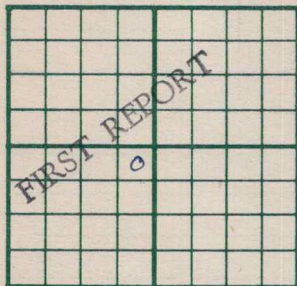County Ellis State KansasSec. 11 (Blk. Twp.) 13 (Sur. Rge.) 16W Map No.Operator Jackson & LindsleyWell No. 1 Farm RiedelElev. Location NE NE SW330 Ft. From N Line SW330 Ft. From E Line Quarter

NOV 15 1950

1st. Report

Completion

Remarks Amerda DHM

Spudding Date

Drlg. Data WildcatLocation

J. E. TYRA

County Ellis State KansasSec. 11 (Blk.) 13 (Sur.) 16W Map No.Operator Jackson & LindsleyWell No. 1 Farm RiedelElev. 1955 Location NE NE SW330 Ft. From N Line SW330 Ft. From E Line Quarter1st. ReportCompletion DEC 6 1950Remarks WildcatSpudding DateDrlg. Data D & A TD 34668" @ 130 Anhy 1065 Top. 2904Stain 3087-99 Heeb. 3121 Dodge 3138Lans. 3172 Stain 3200-02 DST 3075-3265open 75 min. Rec. 75' mud BHP 750#Arb. 3436 TD 3466 D & A

J. E. TYRA