

Map No. _____ Sec. 19 Twp. 27 R. 6
Well No. 4 Boellner Farm _____
Empire Company _____

NORTH

WEST

EAST

SOUTH

FIRST REPORT

Location _____

Drilling Remarks:

Rig up _____

Drilling Remarks:

RECORD

Cased _____ in. _____ ft.

Sand _____

Gas _____

Oil _____

Total Depth _____

PRODUCTION

1st 24 hrs Nat.

1st 24 hrs. after shot_____

Gas _____ cu. ft.


Dry Hole_____

Abandoned

Map No. _____ Sec. 19 Twp. 27 R. 6Well No. 4 Boellner Farm _____
Empire Company _____1320 Ft. from N. Line

_____ Ft. from S. Line

_____ Ft. from E. Line

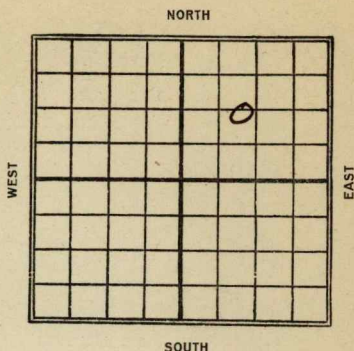1120 Ft. from W. LineDate
1923

REPORT

1/6 Org. 510'
3/22 Stand 2725-45-Top
line 2775-D+G 2833'

KANSAS 11

Map No. _____ Sec. 19 Twp. 27 R. 6

Well No. 4 Baellner

Empire Company

Contractor

FIRST REPORT

SECTION PLAT

1320 Ft. from N. Line

_____ Ft. from S. Line

_____ Ft. from E. Line

1120 Ft. from W. Line

Location _____

Rig up _____

Drilling and Remarks:

20 lg. 510

RECORD

Cased _____ in., _____ ft.

Sand _____

Gas _____

Oil _____

Total Depth _____

PRODUCTION

1st 24 hrs. Nat. _____

1st 24 hrs. after shot _____

Gas _____ Cu. Ft.

Dry Hole _____

Abandoned _____

Date

JAN 6 1923

M. A. BENEAR

191 Scout

Map No. **KANSAS** 11 19 Sec. 27 Twp. 27 R. 6

Well No. 4 *Jaellner*

Empire Company

Contractor


ABANDONED SECTION PLAT

1320' Ft. from N. Line

Ft. from S. Line

Ft. from E. Line

1120' Ft. from W. Line

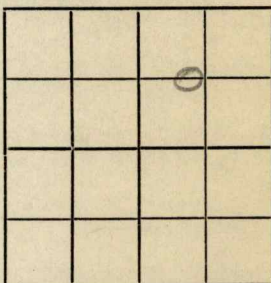

Location

Rig up

Drilling and Remarks:

Sand, { 2725' 2745' }

Top line 2773'

10 + 9

2733'

RECORD

Cased _____ in., _____ ft.

Sand _____

Gas _____

Oil _____

Total Depth _____

PRODUCTION

1st 24 hrs. Nat. _____

1st 24 hrs. after shot _____

Gas _____ Cu. Ft.

Dry Hole _____

Abandoned _____

Date

MAR 22 1923

M. A. BENEAR

192 _____ Scout