

Kansas

Map No. _____ Sec. 19 Twp. 27 R. 6

Well No. 1 Seaton Farm

Philly's Pet

Company

NORTH

WEST

EAST

SOUTH

Location _____

Drilling Remarks:

Rig Up_____

Drilling Remarks:

RECORD

Cased _____ in. _____ ft.

Sand _____

Gas _____

Oil_____

Total Depth_____

PRODUCTION

1st 24 hrs. Nat.

1st 24 hrs. after shot

Gas _____ cu. ft.

Dry Hole _____

Abandoned _____

Map No. _____ Sec. 10 Twp. 27 R. 6


Well No. # 1 Degler Farm
Phillips Pet Company

200 Ft. from N, Line

Ft. from S. Line

Ft. from E. Line

1120 Ft. from W. Line

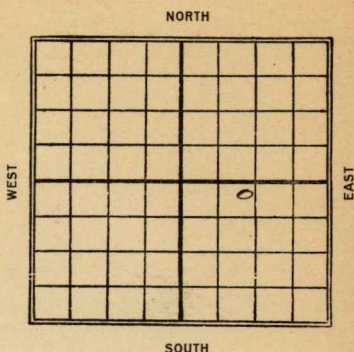

Date _____

Date
1922

REPORT

5/21

Rig Bldg

7/22

Top Ld 2700'

402702 TD 2726

Shot 40 gts

Swabbing 526 Bbls

Map No. 11 Kans Sec. 19 Twp. 27 R. 6Well No. 1 Sec. linePhillips Pet Company

Contractor

FIRST REPORT

SECTION PLAT

200 Ft. from N. Line

----- Ft. from S. Line

----- Ft. from E. Line

1120 Ft. from W. Line

RECORD

Location -----

Cased ----- in., ----- ft.

Rig up -----

Sand -----

Drilling and Remarks:

Gas -----

Oil -----

Total Depth -----

PRODUCTION

1st 24 hrs. Nat. -----

1st 24 hrs. after shot -----

Gas ----- Cu. Ft.

Dry Hole -----

Abandoned -----

Date

MAY 21 1922

M. A. BENEAR

191

Scout

Map No. *Raus 11* Sec. *19* Twp. *27* R. *6*Well No. *1 Sigler*
Phillips pet. Company _____

Contractor _____

COMPLETED SECTION PLAT

200 Ft. from N. Line

Ft. from S. Line

Ft. from E. Line

1120 Ft. from W. Line

		0	

Location _____

Rig up _____

Drilling and Remarks:

Top sand, 2700'
7.0.2702. 7.0.2726
shot 40 qts
swapping
526 lbs.

RECORD

Cased _____ in., _____ ft

Sand _____

Gas _____

Oil _____

Total Depth *2726*

PRODUCTION

1st 24 hrs. Nat. _____

1st 24 hrs. after shot _____

Gas _____ Cu. Ft

Dry Hole _____

Abandoned _____

Date

JUL 22 1922 191

M. A. BENEAR

Scou _____