


Kansas

Map No. _____ Sec. 30 Twp. 23 R. 13

Well No. 1 Evans Farm _____

J. Gillespie Company _____

NORTH

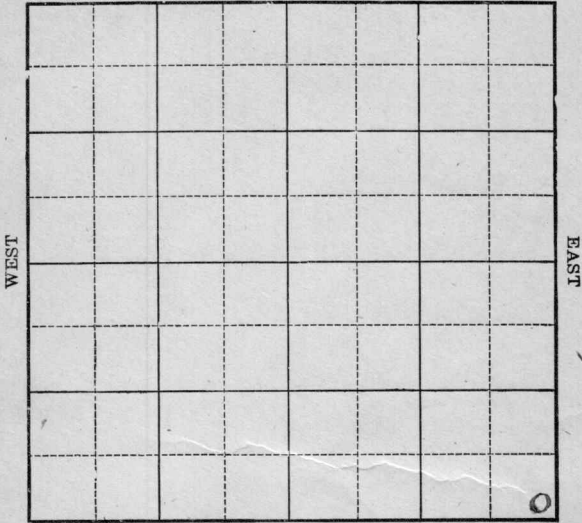

Location _____

Rig Up _____

Drilling Remarks:

Drilling Remarks:

RECORD

PRODUCTION

Cased _____ in. _____ ft.

1st 24 hrs. Nat. _____

Sand _____

1st 24 hrs. after shot _____

Gas _____

Gas _____ cu. ft.

Oil _____

Dry Hole _____

Total Depth _____

Abandoned _____

Map No. _____ Sec. 30 Twp. ~~28~~²³ R. 13


Well No. #1 Evans Farm
Gillespie Company

_____ Ft. from N. Line

200 Ft. from S. Line

200 Ft. from E. Line

_____ Ft. from W. Line

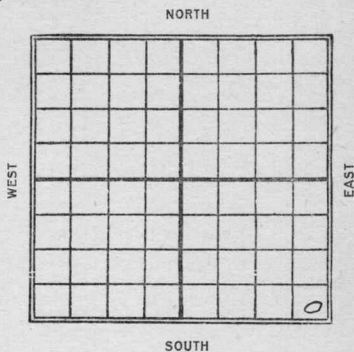

Date
1922

REPORT

3/20
5/21

Dlg 300'
D&A 1346'

Kansas

Map No. *K17* Sec. *30* Twp. *23* R. *13*

Well No. *1 Evans*

Gullespie Company

Contractor

SECTION PLAT

FIRST REPORT

-----Ft. from N. Line

200 Ft. from S. Line

200 Ft. from E. Line

-----Ft. from W. Line

Location -----

Rig up -----

Drilling and Remarks:

*20 lg.
300*

RECORD

Cased ----- in., ----- ft.

Sand -----

Gas -----

Oil -----

Total Depth -----

PRODUCTION

1st 24 hrs. Nat. -----

1st 24 hrs. after shot -----

Gas ----- Cu. Ft.

Dry Hole -----

Abandoned -----

Date

MAR 20 1922

M. A. BENEAR

191

Scout

17 *Kans.*
Map No. _____ Sec. *30* Twp. *23* R. *13*

Well No. *1 Evans*
Gillespie _____ Company
_____ Contractor

ABANDONED

SECTION PLAT

_____ Ft. from N. Line
200 _____ Ft. from S. Line
200 _____ Ft. from E. Line
 _____ Ft. from W. Line

Location _____

Rig up _____

Drilling and Remarks:

2019
1746

RECORD

Cased _____ in., _____ ft.

Sand _____

Gas _____

Oil _____

Total Depth _____

PRODUCTION

1st 24 hrs. Nat. _____

1st 24 hrs. after shot _____

Gas _____ Cu. Ft.

Dry Hole _____

Abandoned _____

Date _____

MAY 21 1922

M. A. BENEAR

_____ 191 _____

_____ Scout