

KANSAS

Greenwood

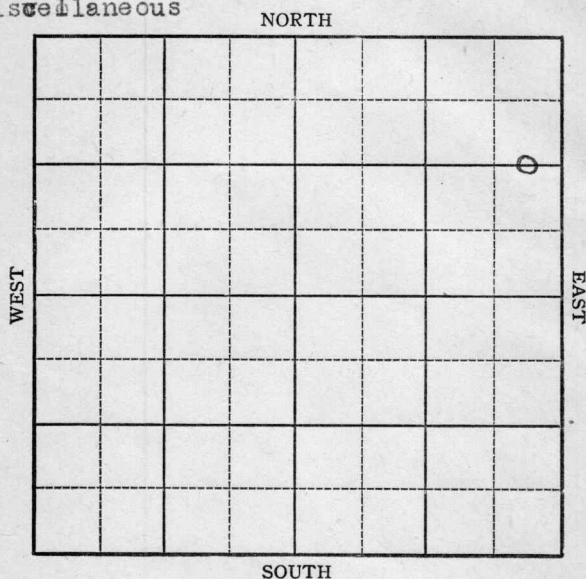
FORM 51 5M PETROL

Section 32 Township 23 Range 17E

Well No. #1 Berry

Company Rock Hill Stone & Gravel

Miscellaneous



KANSAS

Greenwood

Sec. 32 Twp. 23 R. 13E

Well No. #1 Berry Farm

Rockhill Stone & Gravel Company

Miscellaneous

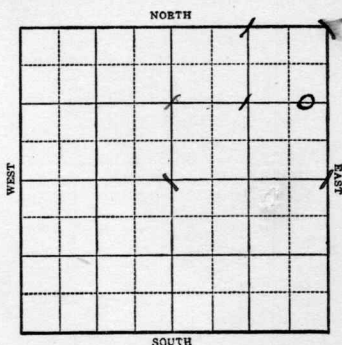
1320 Ft. from N. Line

_____ Ft. from S. Line

330 Ft. from E. Line

_____ Ft. from W. Line

C E L N E



R E P O R T

1943

12/22

Machine

12/29

"

1944

1/5

Spud SD

1/12

SD

1/26

12" @ 42

10" @ 300

8" @ 812

Drlg. 870'

2/2

1100 Run 8"

2/9

5" @ 1610

PBP

Miss 1610'

TD 1624'

2-16

TD 1627'

20 qts 1616-27'

Pipe collapsed

2/ 3

SD

3/1

"

3/8

5" @ 1610

Miss 1610

TD 1627

20 qts 1616-24

Pump 50 Pot.

Gravity 36.4

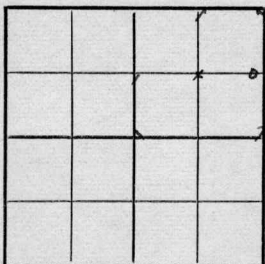
COMPLETED

KANSAS

Map No. 17 Sec. 32 Twp. 23 R. 13EWell No. 1 BerryRock Hill Stone & Gravel CompanyFIRST REPORT Contractor

C E L N E

SECTION PLAT

1320 Ft. from N. Line Ft. from S. Line330 Ft. from E. Line Ft. from W. LineMis cellaneousLocation Rig up

Drilling and Remarks:

Mach ine

RECORD

Cased in., ft.Sand Gas Oil Total Depth

PRODUCTION

1st 24 hrs. Nat. 1st 24 hrs. after shot Gas Cu. Ft.Dry Hole Abandoned

Date

DEC 22 1943

19

S. J. LEWIS

Scout

KANSAS

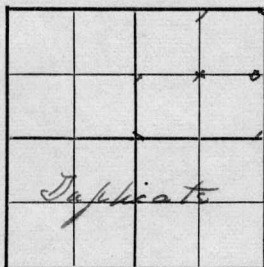
Map No. 17 Sec. 32 Twp. 23 R. 13EWell No. 1 BerryRockhill Stone & Gravel Company

FIRST REPORT

Contractor

C E L N E

SECTION PLAT

1320 Ft. from N. Line Ft. from S. Line330 Ft. from E. Line Ft. from W. Line

Miscellaneous

Location Rig up

Drilling and Remarks:

5" - 1610PBP

RECORD

Cased in., ft.Sand Gas Oil Total Depth

PRODUCTION

1st 24 hrs. Nat. 1st 24 hrs. after shot Gas Cu. Ft.Dry Hole Abandoned

Date

FEB 9 1944 19S. J. LEWIS Scout

KANSAS

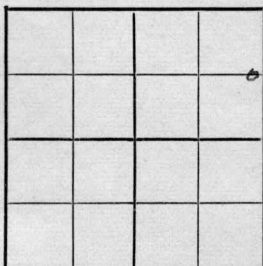
Map No. 17 Sec. 32 Twp. 23 R. 13EWell No. 1 BerryRock Hill Stone & Gravel Company

COMPLETED

Contractor

C E L N E

SECTION PLAT

1320 Ft. from N. Line

_____ Ft. from S. Line

330 Ft. from E. Line

_____ Ft. from W. Line

Miscellaneous

Location _____

Rig up _____

Drilling and Remarks:

*Mia's 1610**5-11-1610**209 to 1616-24**Aug 50 P.D.**36 1/2 ft*

RECORD

Cased _____ in., _____ ft.

Sand _____

Gas _____

Oil _____

Total Depth 1627

PRODUCTION

1st 24 hrs. Nat. _____

1st 24 hrs. after shot _____

Gas _____ Cu. Ft.

Dry Hole _____

Abandoned _____

Date

MAR 8 1944 19

S. J. LEWIS Scout