
Form 51-10M-7-20-CroMac Kansas

Map No. ____ Sec. 32 Twp. 23 R. 13

Well No. 2 Berry Farm

Indal Company

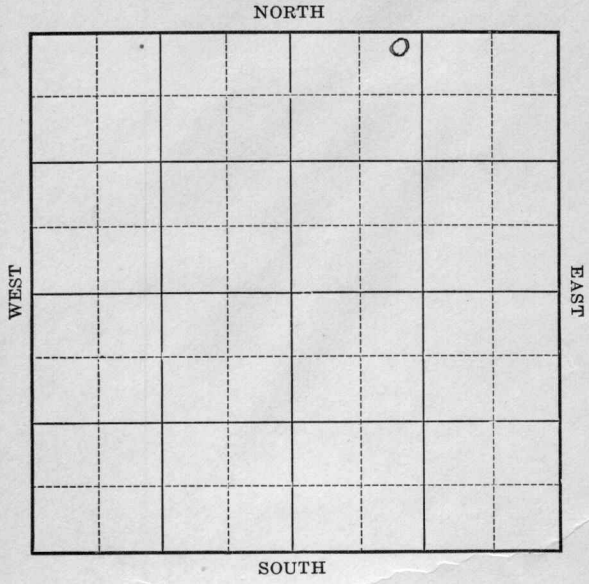

Location _____

Drilling Remarks:

Rig Up _____

Drilling Remarks:

RECORD

Cased _____ in. _____ ft.

Sand _____

Gas _____

Oil _____

Total Depth _____

PRODUCTION

1st 24 hrs. Nat. _____

1st 24 hrs. after shot _____

Gas _____ cu. ft.

Dry Hole _____

Abandoned _____

Form 252A 5M 8-21 PALACE-TULSA 6835

Map No. _____ Sec. 32 Twp. 23 R. 13

Well No. # 2 Berry Farm


Tidal Company

200 Ft. from N, Line

_____ Ft. from S. Line

_____ Ft. from E. Line

~~1320~~ 660 Ft. from W. Line

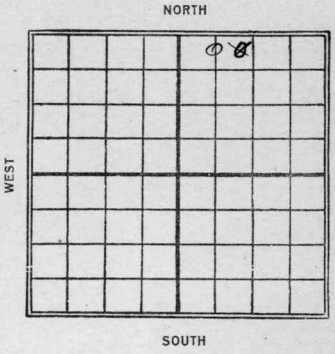

Date 1932	REPORT
7/15	Rig.
7/22	1749-36 TD
	40 qts 15 Bbls

Form 26—1M—4-19—Mid-West

Map No. Kas 17 Sec. 32 Twp. 23 R. 13

Well No. 2 Berry

Tidal Company

Contractor

FIRST REPORT


200 Ft. from N. Line

Ft. from S. Line

Ft. from E. Line

1120 Ft. from W. Line

SECTION PLAT

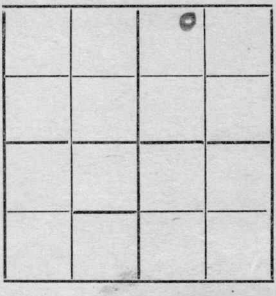

Location

Rig up

Drilling and Remarks:

Rig.

RECORD

Cased in., ft.

Sand

Gas

Oil

Total Depth

PRODUCTION

1st 24 hrs. Nat.

1st 24 hrs. after shot

Gas Cu. Ft.

Dry Hole

Abandoned

Date

JUL 15 1922

191

M. A. BENEAR Scout

Form 26—1M—4-19—Mid-West

Map No. Rand 17 Sec. 32 Twp. 23 R. 13


Well No. 2 Berry

Tidal Oil Company

COMPLETED Contractor

[redacted]

SECTION PLAT

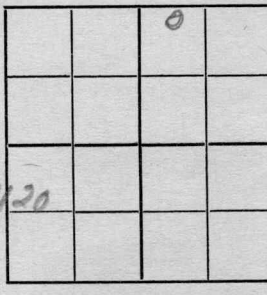

200' Ft. from N. Line

Ft. from S. Line

Ft. from E. Line

660 Ft. from W. Line corrected from 1120

Location

Rig up

Drilling and Remarks:

shot 40 qts.

RECORD

Cased in., f

Sand

Gas

Oil 1729-36

Total Depth 1736

PRODUCTION

1st 24 hrs. Nat.

1st 24 hrs. after shot 15

Gas Cu. F

Dry Hole

Abandoned

Date

JUL 22 1922 191

M. A. BENEAR

Scou