


Map No. _____ Sec. 19 Twp. 27 R. 6

Well No. 7 Snodgrass Farm

Derby

Company

NORTH

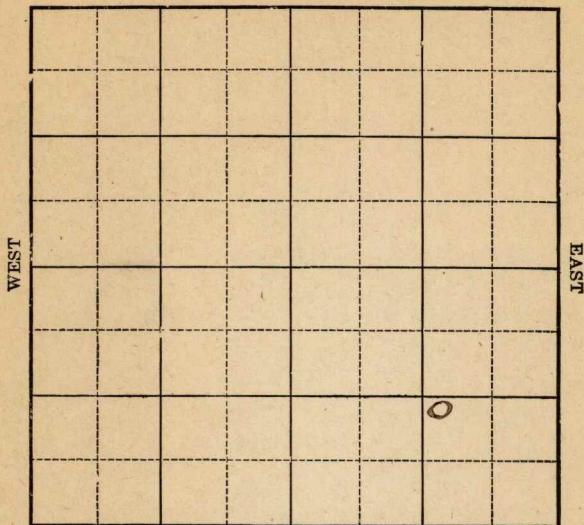

Location _____

Drilling Remarks:

Rig Up

Drilling Remarks:

RECORD

Cased _____ in. . _____ ft.

Sand _____

Gas _____

Oil_____

Total Depth _____

FIRST REPORT
COMPLETED

PRODUCTION

1st 24 hrs. Nat. _____

1st 24 hrs. after shot

Gas cu ft

Dry Hole

Abandoned

Map No. _____ Sec. 19 Twp. 27 R. 6


Well No. 7 Snodgrass Farm
Derby Company
NORTH

Ft. from N. Line

1120 Ft. from S. Line

1120 Ft. from E. Line

_____ Ft. from W. Line

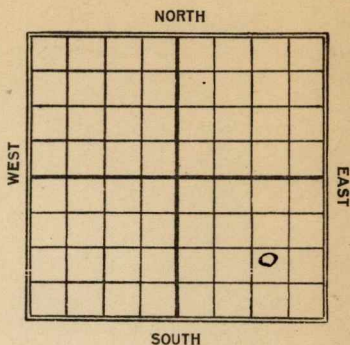[illegible]

Map No. **KANSAS** Sec. **19** Twp. **27** R. **6**
 Well No. **7** **Smadgrass**
Lecky Company
 Contractor

FIRST REPORT

SECTION PLAT

_____ Ft. from N. Line
1120 Ft. from S. Line
1120 Ft. from E. Line
 _____ Ft. from W. Line

			0

Location _____

Rig up **✓** _____

Drilling and Remarks:

RECORD

Cased _____ in., _____ ft.

Sand _____

Gas _____

Oil _____

Total Depth _____

PRODUCTION

1st 24 hrs. Nat. _____

1st 24 hrs. after shot _____

Gas _____ Cu. Ft.

Dry Hole _____

Abandoned _____

Date

SEP 16 1922 191

M. A. BENEAR

Scout

Map No. **KANSAS** 11 Sec. **19** Twp. **27** R. **6**Well No. **7 Snodgrass**Company **Herby oil**

Contractor

COMPLETED SECTION PLAT

			0

Ft. from N. Line

1120 Ft. from S. Line**1120** Ft. from E. Line

Ft. from W. Line

Location

Rig up

Drilling and Remarks:

shot 40 ft

RECORD

Cased in., ft.

Sand

Gas

Oil **2692-2704**Total Depth **2719**

PRODUCTION

1st 24 hrs. Nat.

1st 24 hrs. after shot **40**

Gas Cu. Ft.

Dry Hole

Abandoned

Date

NOV 24 1922**M. A. BENEAR**

191

Scout