


Section 19 Township 27 Range 6 E

Well No. # 8 Snodgrass

Company Magnolia Pet.

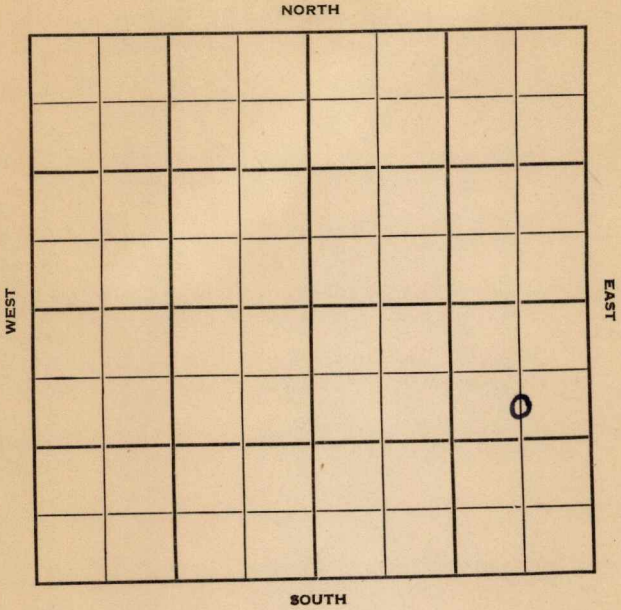

Sec. 19 Twp. 27 R. 6E

Well No. #8 Snodgrass Farm

Magnolia Pet. Company

Contractor


990 Ft. from N. Line

Ft. from S. Line

660 Ft. from E. Line

Ft. from W. Line

C S L N E S E

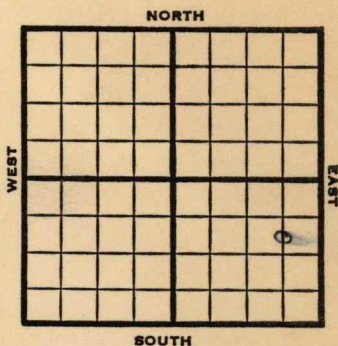

1952 **Elev. 1344'** REPORT

11/18 Spud 11-16-52
8" @ 102'
Drlg. 944'

12/17 Spud 11-16-52
D&A
TD 2711'
8" @ 102
Bart 2687
TD 2711
5" @ 2689
Lans 1778
CO to 2711 55 A
B/7 gwph PB 2703 B/7 gwph
D&A

ABANDONED

County Butler State Kansas

Sec. 19 (Blk. 27) (Sur. 6E) Map No.

Operator Magnolia Pet.

Well No. 8 Farm Snodgrass

Elev. 1344 Location C S L NE SE

ABANDONED

990 Ft. From N Line SE

660 Ft. From E Line Quarter

Ist. Report

Completion DEC 17 1952

Remarks

Spudding Date 11-16-52

Drlg. Data D & A TD 2711

8" @ 102 Bart. 2687 TD 2711

5" @ 2689 Lans. 1778 CO to 2711

55 A B/ 7 gwph PB 2703 B/ 7 gwph

D & A