


Map No. Kansas Sec. 19 Twp. 27 R. 6
Well No. 4 Winkle (Van Winkle) Farm
Skelly Oil Company

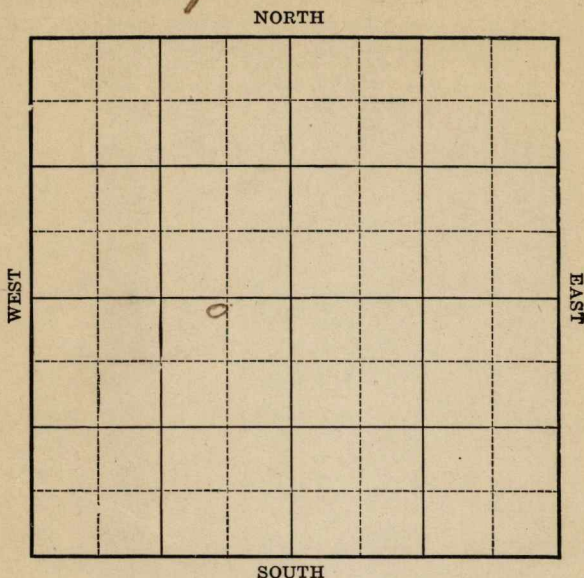

Location _____
Drilling Remarks _____

Rig Up _____
Drilling Remarks _____

RECORD

Cased _____ in. _____ ft.
Sand _____
Gas _____
Oil _____
Total Depth _____

PRODUCTION

1st 24 hrs. Nat. _____
1st. 24 hrs. after shot _____
Gas _____ cu. ft.
Dry Hole _____
Abandoned _____


Map No. Kaw Sec. 19 Twp. 27 R. 6Well No. 4 Skelly Farm _____
Skelly Oil Company _____200 Ft. from N. Line

_____ Ft. from S. Line

700 Ft. from E. Line

_____ Ft. from W. Line

NORTH

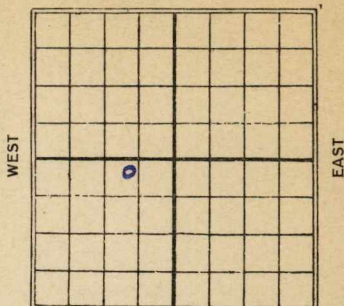

SOUTH

C

Date

REPORT

19254/12 Rig up.6/19 Rig6/26 —7/13 Spud7/10 dr. 5277/17 10407/24 15257/31 2700'8/7 set 6" 3423'8/14 try to 2735-44 tan'ole
not will shoot8/20 2735-2749 40 gts
15 Bbls

Map No. 11 Sec. 19 Twp. 27 R. 6Well No. 4 WinkOil Co Company

Contractor

SECTION PLAT

200 Ft. from N. Line

Ft. from S. Line

700 Ft. from E. Line

Ft. from W. Line

	o		

FIRST REPORTS

Location ✓Rig up ✓

Drilling and Remarks:

RECORD

Cased _____ in., _____ ft.

Sand _____

Gas _____

Oil _____

Total Depth _____

PRODUCTION

1st 24 hrs. Nat. _____

1st 24 hrs. after shot _____

Gas _____ Cu. Ft.

Dry Hole _____

Abandoned _____

Date

JUN 12 1925CHAS. L. SHERWOOD192 Scout

Map No. 11 KANSAS Sec. 19 Twp. 27 R. 6
 Well No. 4 Wink

Bjelly oil Co Company

Contractor

COMPLETED

SECTION PLAT

200 Ft. from N. Line

Ft. from S. Line

700 Ft. from E. Line

Ft. from W. Line

	o		

Location

Rig up

Drilling and Remarks:

40
15 bhs.

RECORD

Cased _____ in. _____ ft.

Sand 2735-2749

Gas _____

Oil _____

Total Depth 2749

PRODUCTION

1st 24 hrs. Nat. _____

1st 24 hrs. after shot _____

Gas _____ Cu. Ft.

Dry Hole _____

Abandoned _____

Date

AUG 20 1925

CHAS. L. SHERWOOD

192 Scout