


Section 21 Township 23 Range 13-E

Well No. 12 - Jones

Company Superior O&G

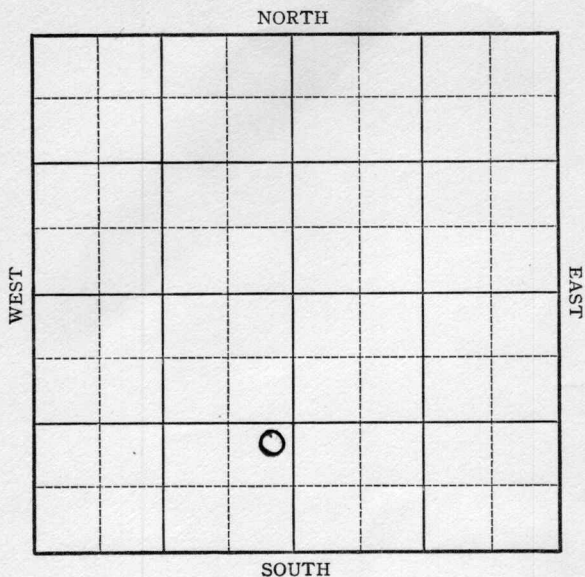

Sec. 21 Twp. 23 R. 13-E

Well No. #12 Jones Farm


Superior O & G Company

_____ Ft. from N. Line

1210 Ft. from S. Line

200 Ft. from E. Line

_____ Ft. from W. Line

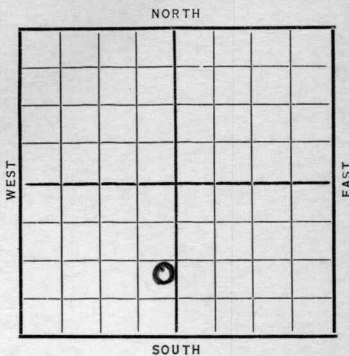

Date	REPORT
1937	
6/9	Location
6/19	R. U.
6/25	Drlg. 550'.
7/2	10" @ 876'.
7/9	" "
7/16	8" @ 1442'. Miss. 1658'.
	6" @ 1662'. T.D. 1707'.
	Acidizing.
7/21	Miss 1658'
	6" @ 1662'
	TD 1707'
	2000 acid
	Pot. 30
	COMPLETED

KANSAS

Greenwood

Map No. 17^m Sec. 21 Twp. 23 R. 13^F

Well No. 12 - Jones

Superior O & G Company

Contractor

FIRST REPORT

SECTION PLAT

_____ Ft. from N. Line

1210 Ft. from S. Line

200 Ft. from E. Line

_____ Ft. from W. Line

see correction ticket on well #11

Location ✓

Rig up _____

Drilling and Remarks:

RECORD

Cased _____ in., _____ ft.

Sand _____

Gas _____

Oil _____

Total Depth _____

PRODUCTION

1st 24 hrs. Nat. _____

1st 24 hrs. after shot _____

Gas _____ Cu. Ft.

Dry Hole _____

Abandoned _____

Date

JUN 9 1937 19

H. D. Hatfield Scout

Greenwood

Map No. 17^M Sec. 21 Twp. 23 R. 13^E

Well No. 12-Jones

Superior O & G Company

Contractor

COMPLETED

SECTION PLAT

_____ Ft. from N. Line
1210 Ft. from S. Line
200 Ft. from E. Line
_____ Ft. from W. Line

		0	

Location _____

Rig up _____

Drilling and Remarks:

2000 Acid

Pot - 30

RECORD

Cased 6 in., 1662 ft.

Sand MISS 1658

Gas _____

Oil _____

Total Depth 1707

PRODUCTION

1st 24 hrs. Nat. _____

1st 24 hrs. after shot _____

Gas _____ Cu. Ft.

Dry Hole _____

Abandoned _____

Date

JUL 21 1937

19

H. D. Hatfield

Scout