


Section 21 Township 23 Range 13E

Well No. 14 Jones

Company Superior

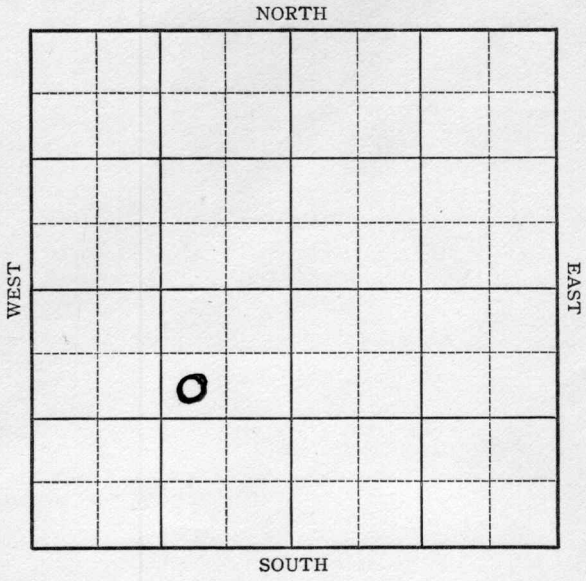

KANSAS

Greenwood

Map No. 17M Sec. 21 Twp. 23 R. 13E

Well No. 14-Jones

Superior Company

Contractor

FIRST REPORT

SECTION PLAT

	0		

 Ft. from N. Line

990 Ft. from S. Line

990 Ft. from E. Line

 Ft. from W. Line

Location

Rig up

Drilling and Remarks:

Spud

RECORD

Cased in., ft.

Sand

Gas

Oil

Total Depth

PRODUCTION

1st 24 hrs. Nat.

1st 24 hrs. after shot

Gas Cu. Ft.

Dry Hole

Abandoned

Date

JUL 28 1937

H. D. Hatfield Scout

KANSAS

Map No. 17^m Sec. 21 Twp. 23 R. 13EWell No. 14-JonesSuperior

Company

Contractor

COMPLETED

SECTION PLAT

	0		

_____ Ft. from N. Line

990 Ft. from S. Line990 Ft. from E. Line

_____ Ft. from W. Line

Location _____

Rig up _____

Drilling and Remarks:

2000 and96 bbls oil
10 bbls water

RECORD

Cased 6 in., 1720 ft.Sand Miss L. 1720

Gas _____

Oil _____

Total Depth 1742

PRODUCTION

1st 24 hrs. Nat. _____

1st 24 hrs. after shot _____

Gas _____ Cu. Ft.

Dry Hole _____

Abandoned _____

Date

SEP 8 1937

19

H. D. Hatfield

Scout