


Section 21 Township 23 Range 13E

Well No. #4 Jones "E"

Company Sunray

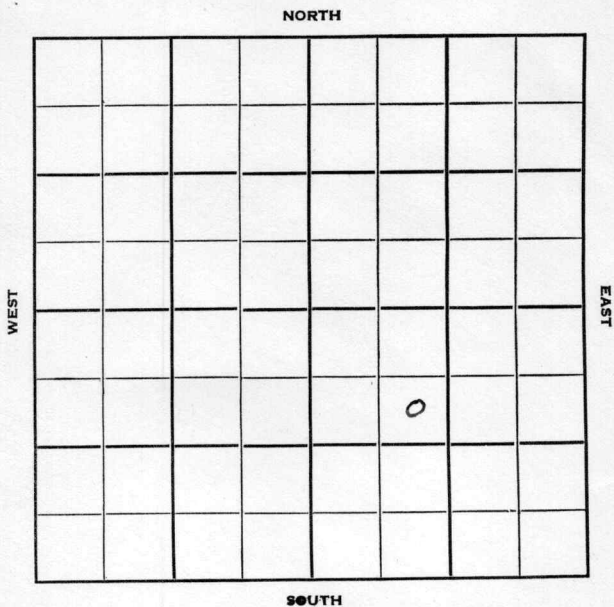

Sec. 21 Twp. 23 R. 13E

Well No. #4 Jones "E" Farm

Sunray Company

Jackman & Jackman Contr. Contractor


990' Ft. from N. Line

\_\_\_\_\_ Ft. from S. Line

\_\_\_\_\_ Ft. from E. Line

990' Ft. from W. Line

SE NW SE

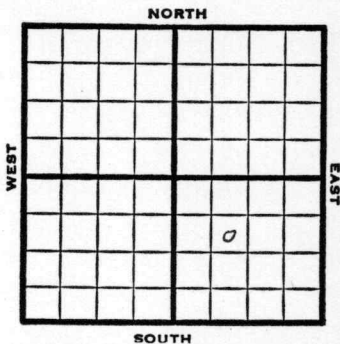

1950

Elev. 1140' **REPORT**

12/13

Spud 12-8-50  
10" @ 82'  
Drlg. 190'

12/27

Spud 12-8-50  
Oil Well TD 1701  
10" @ 82' Miss 1691  
DST 1701-16 opn 1 hr  
Rec. 5' free oil 60' hocm  
5" @ 1701 TD 1716  
S/2 bopd Comp. 40 bopd

**COMPLETED**



