
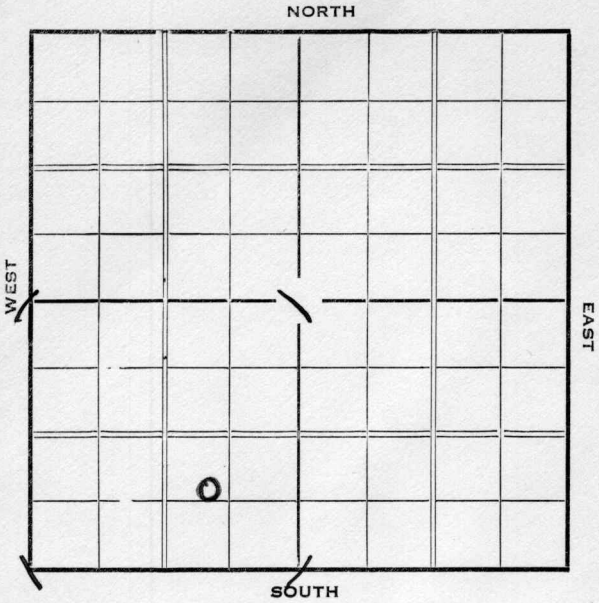


Section 21 Township 23 Range 13-E

Well Number #13 Jones

Company Superior Oil

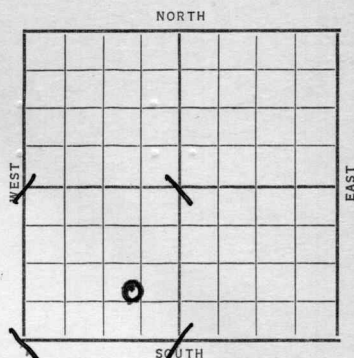

Sec. 21 Twp. 23 R. 13-EWell No. #13 Jones FarmSuperior Oil Company Ft. from N. Line670 Ft. from S. Line720 Ft. from E. Line Ft. from W. Line

Date

REPORT

1937

6/30

Location

7/9

"

7/16

Drlg. 370'.

7/23

Drlg. 700'.

7/30

Drlg. 1075'.

8/6

8" @ 1260'. Drlg. 1555'.

8/13

Miss. 1650'. 7" @ 1669'.

T.D. 1717' S.O. Rig'n up to
deepen.

8/20

"

8/28

Drlg. 1900'.

9/3

"

"

9/10

5" @ 2070'. S.O. & W. 2076'.

Drlg. 2080'.

9/17

"

"

OVER

1937

9/22 Sil. 2069'.

T.D. 2106'.

ABANDONED

KANSAS *Greenwood*Map No. *17^M* Sec. *21* Twp. *23* R. *13E*Well No. *13-Jones**Superior Oil* Company

Contractor

FIRST REPORT

SECTION PLAT

	0		

_____ Ft. from N. Line

670 Ft. from S. Line*720* Ft. from E. Line

_____ Ft. from W. Line

Location _____

Rig up _____

Drilling and Remarks:

RECORD

Cased _____ in., _____ ft.

Sand _____

Gas _____

Oil _____

Total Depth _____

PRODUCTION

1st 24 hrs. Nat. _____

1st 24 hrs. after shot _____

Gas _____ Cu. Ft.

Dry Hole _____

Abandoned _____

Date

JUN 30 1937 19

H. D. Hatfield

Scout

KANSAS

Map No. 17M Sec. 21 Twp. 23 R. 13EWell No. 13-Jones
Superior Oil Company

Contractor

SECTION PLAT

	0		

Ft. from N. Line

670 Ft. from S. Line720 Ft. from E. Line

Ft. from W. Line

ABANDONED

Location _____

Rig up _____

Drilling and Remarks:

RECORD

Cased _____ in., _____ ft.

Sand Shivers 2069

Gas _____

Oil _____

Total Depth 2106

PRODUCTION

1st 24 hrs. Nat. _____

1st 24 hrs. after shot _____

Gas _____ Cu. Ft.

Dry Hole _____

Abandoned _____

Date

SEP 22 1937 19

H. D. Hatfield

Scout