

Kansas

Map No. _____ Sec. 20 Twp. 27 R. 6Well No. 1 Clark Farm _____Empire Gas & Fuel Company _____

NORTH

WEST

EAST

SOUTH

FIRST REPORT

Location _____

Drilling Remarks:

Rig Up _____

Drilling Remarks:

RECORD

Cased _____ in. _____ ft.

Sand _____

Gas _____

Oil _____

Total Depth _____

PRODUCTION

1st 24 hrs. Nat. _____

1st 24 hrs. after shot _____

Gas _____ cu. ft.

Dry Hole _____

Abandoned _____

Map No. _____ Sec. 20 Twp. 27 R. 6


Well No. 1 Clark Farm
Empire Gas & Fuel Company

200 Ft. from N. Line

_____ Ft. from S. Line

200 Ft. from E. Line

_____ Ft. from W. Line

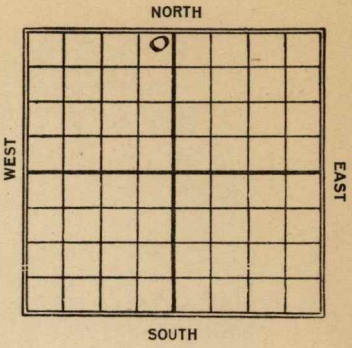

Date	REPORT
1922	
9/16	Rig.
10/21	Sand 2710-27 - shot 40 gts. 25 Bbls. T-D. 27.30'

Map No. **KANSAS** Sec. **20** Twp. **27** R. **6**Well No. **1 Clark****Empire Gas & Fuel** Company

Contractor

FIRST REPORT**SECTION PLAT****200** Ft. from N. Line

Ft. from S. Line

200 Ft. from E. Line

Ft. from W. Line

Location

Rig up **✓✓**

Drilling and Remarks:

RECORD

Cased _____ in., _____ ft.

Sand _____

Gas _____

Oil _____

Total Depth _____

PRODUCTION

1st 24 hrs. Nat. _____

1st 24 hrs. after shot _____

Gas _____ Cu. Ft.

Dry Hole _____

Abandoned _____

Date

SEP 16 1922**M. A. BENEAR**

191

Scout

Map No. *N. 20* Sec. *27* Twp. *6* R. *6*Well No. *1 Clark**Empire Gas & Fuel* Company

Contractor

COMPLETED

SECTION PLAT

200 Ft. from N. Line

Ft. from S. Line

200 Ft. from E. Line

Ft. from W. Line

	0		

Location

Rig up

Drilling and Remarks:

shot 40 ft

RECORD

Cased _____ in., _____ ft.

Sand _____

Gas _____

Oil *2710-2727*Total Depth *2730*

PRODUCTION

1st 24 hrs. Nat. _____

1st 24 hrs. after shot *25*

Gas _____ Cu. Ft.

Dry Hole _____

Abandoned _____

Date

OCT 21 1922

191

M.B.

Scout