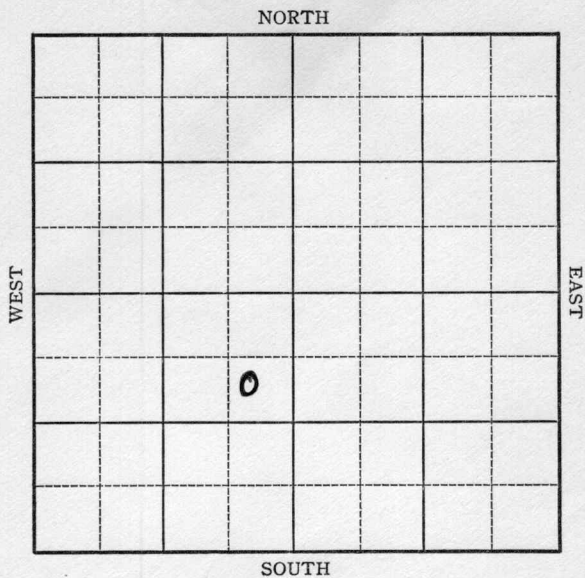
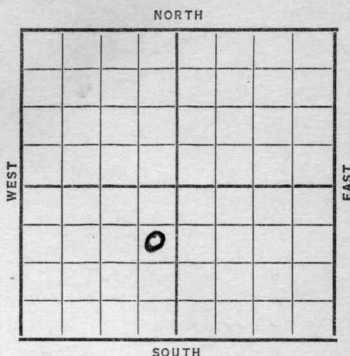


Section 21 Township 23 Range 13-EWell No. 15 JonesCompany Superior Oil

Sec. 21 Twp. 23 R. 13-EWell No. #15 Jones FarmSuperior Oil Company830 Ft. from N. Line Ft. from S. Line405 Ft. from E. Line Ft. from W. Line

Date	REPORT
1937	
10/6	12" @ 410'. SD 492'.
	Repairs.
10/15	Drlg. 670'.
10/22	Drlg. 800'.
10/29	T.D. 904'. Rng. 10".
11/5	10" @ 904'. Drlg. 1034'.
11/12	8" @ 1340'. Drlg. 1480'.
11/19	" " " "
11/23	6" @ 1690'.
	Miss. 1683'.
	T.D. 1719'.
	2000 acid.
	Potential 48 bbls.
	COMPLETED

Greenwood KANSAS

Map No. 17^M Sec. 21 Twp. 23 R. 13EWell No. 15 JonesSuperior Oil

Company

Contractor

SE NE SW

FIRST REPORT

SECTION PLAT

830¹ Ft. from N. Line Ft. from S. Line405 Ft. from E. Line Ft. from W. LineLocation Rig up

Drilling and Remarks:

12" - 410SD 492Repairs

RECORD

Cased in., ft.Sand Gas Oil Total Depth

PRODUCTION

1st 24 hrs. Nat. 1st 24 hrs. after shot Gas Cu. Ft.Dry Hole Abandoned

Date

OCT - 6 1937H. D. Hatfield19Scout

Greenwood KANSAS

Map No. 17th Sec. 21 Twp. 23 R. 13EWell No. 15 JonesSuperior Oil Company

Contractor

COMPLETED

SE NE SW

830 Ft. from N. Line Ft. from S. Line405 Ft. from E. Line Ft. from W. Line

SECTION PLAT

Location Rig up

Drilling and Remarks:

2000 acidPOT-48

RECORD

Cased 6 in., 1690 ft.Sand MISS 1683Gas Oil Total Depth 1719

PRODUCTION

1st 24 hrs. Nat. 1st 24 hrs. after shot Gas Cu. Ft.Dry Hole Abandoned

Date

NOV 23 1937

19

H. D. Hatfield

Scout