

Map No. _____ Sec. 20 Twp. 27 R. 6Well No. 36 Clark Farm _____Hoyt Etal Company _____

NORTH

WEST

EAST

SOUTH

Location _____

Drilling Remarks:

Rig Up _____

Drilling Remarks:

RECORD

Cased _____ in. _____ ft.

Sand _____

Gas _____

Oil _____

Total Depth _____

PRODUCTION

1st 24 hrs. Nat. _____

1st 24 hrs. after shot _____

Gas _____ cu. ft.

Dry Hole _____

Abandoned _____

Map No. _____ Sec. 20 Twp. 27 R. 6


Well No. 3 Clark Farm _____
Hoyt Et al Company _____

_____ Ft. from N. Line

990 Ft. from S. Line

_____ Ft. from E. Line

990 Ft. from W. Line

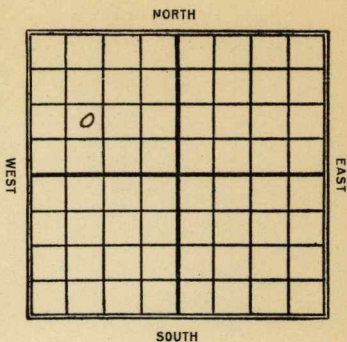

Date	REPORT
1923	
2/6	Location
3/22	Sand 2709-23 Shot
	400ft. 50 Bbl.

Map No. KANSAS Sec. 20 Twp. 27 R. 6Well No. 3 ClarkHayes et al Company

Contractor

FIRST REPORT

SECTION PLAT

0			

Ft. from N. Line

990 Ft. from S. Line

Ft. from E. Line

990 Ft. from W. Line

Location ✓✓

Rig up

*Drilling and Remarks:

RECORD

Cased _____ in., _____ ft.

Sand _____

Gas _____

Oil _____

Total Depth _____

PRODUCTION

1st 24 hrs. Nat. _____

1st 24 hrs. after shot _____

Gas _____ Cu. Ft.

Dry Hole _____

Abandoned _____

Date **FEB 6** 1923**M. A. BENEAR**

Map No. **KANSAS** 11 Sec. **20** Twp. **27** R. **6**

Well No. **3 Clark**

Hayt et al. Company

Contractor

COMPLETED

SECTION PLAT

_____ Ft. from N. Line

990' Ft. from S. Line

_____ Ft. from E. Line

990' Ft. from W. Line

Location _____

Rig up _____

Drilling and Remarks:

*sand { 2709
2723
shift 40 ft
50 ft.*

RECORD

Cased _____ in., _____ ft.

Sand _____

Gas _____

Oil _____

Total Depth _____

PRODUCTION

1st 24 hrs. Nat. _____

1st 24 hrs. after shot _____

Gas _____ Cu. Ft.

Dry Hole _____

Abandoned _____

Date

MAR 22 1923

M. A. BENEAR

_____ 192 _____ Scout