

Map No. *ELLIS* **KANSAS** Sec. *12* Twp. *13* R. *16*^W

Well No. *1- Blechart* Farm
Phillips Pet Company

NORTH

							0

WEST

EAST

SOUTH

Location.....

Drilling Remarks

Rig Up.....

Drilling Remarks

RECORD

Cased.....in.....ft.

Sand.....

Gas.....

Oil.....

Total Depth.....

PRODUCTION

1st 24 hrs. Nat.....

1st 24 hrs. after shot.....

Gas.....cu. ft.....

Dry Hole.....

Abandoned.....


Map No. **KANSAS** Sec. 12 Twp. 13 R. 16^W
 Well No. 1- Dechart Farm
Phillips Pet Company

330 Ft. from N. Line

..... Ft. from S. Line

330 Ft. from E. Line

..... Ft. from W. Line

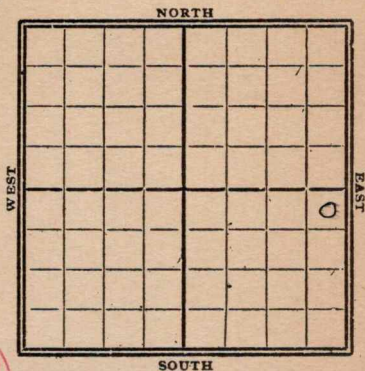

1929

OWNED

Date

REPORT

1/9	Location
1/16	—
1/23	—
1/30	—
2/6	Bldg Rig
2/13	Rig
2/20	J
2/27	Spud
3/6	" 200'
3/13	Drill 480'
3/20	" 1050'
3/27	" 1008'
4/3	" 1720'
4/10	" 1990'
4/16	" 2540'
4/24	" 2650'
5/1	W.R. 5" - 2810
5/8	Log tool 3005
5/15	2nd Oswald sd 3090
	Pay 3118-46 TD. 3160
	35 blks 12 hrs
5/22	HFw 3210-14 - Drill 3245'

5/29- Hrlg 3355

6/5- TD. 3440'

HFW at 3394

Dry & Abandoned

OWDD

1934

1/3- Drilling deeper
will acidize

1/11 C.O.

1/17- C.O. at 1700

1/24 T.D. 3101 H.F.W. - cern 5"

1/31 5" 3110 TD 3140 PB

2/7 Re cement 5" WOC

2/14 Small show 3165 acidizing

2/23- 1000 Hcl acid 76.0 H.

3/1 —

3/9 Cern back to 3130

3/15 " " " 3125

3/22 Pump 45 oil & 35 water

3/28 95 3140 PB 3125 1000

Hcl acid 100 BBl oil &
20 BBl water

COMPLETED

Map No. KANSAS Sec. 12 Twp. 13 R. 16 N

Well No. 1 Dechant

Phillips P & S Company

Contractor

SECTION PLAT

330 Ft. from N. Line

..... Ft. from S. Line

330 Ft. from E. Line

..... Ft. from W. Line

			0

FIRST REPORTS

Location ✓

Rig up

Drilling and Remarks:

RECORD

Cased in., ft.

Sand

Gas

Oil

Total Depth

PRODUCTION

1st 24 hrs. Nat.

1st 24 hrs. after shot

Gas Cu. Ft.

Dry Hole

Abandoned

Date

JAN 9 - 1929 192

S. J. LEWIS Scout

71

Map No. **KANSAS** Sec. 12 Twp. 13 R. 16W

Well No. 1 Dechant

Phillips Pet Company

Contractor

SECTION PLAT

330 Ft. from N. Line

..... Ft. from S. Line

330 Ft. from E. Line

..... Ft. from W. Line

			0

ABANDONED

Location.....

Rig up.....

Drilling and Remarks:

HW 3394

IT 4

RECORD

Cased..... in., ft.

Sand.....

Gas.....

Oil.....

Total Depth 3440

PRODUCTION

1st 24 hrs. Nat.....

1st 24 hrs. after shot.....

Gas..... Cu. Ft.

Dry Hole.....

Abandoned.....

Date

JUN 5 1929

192

S. J. LEWIS Scout

Map No. 71 Sec. 12 Twp. 13 R. 16W

Well No. #1 - polymer

Ashby Company

Contractor

FIRST REPORTS

SECTION PLAT

330 Ft. from N. Line

Ft. from S. Line

330 Ft. from E. Line

Ft. from W. Line

QWD

Location.....

Rig up.....

Drilling and Remarks:

O.T.O. 3440
old well drilled
by phillips.

cleaning out
to acidize

RECORD

Cased.....in.,ft.

Sand.....

Gas.....

Oil.....

Total Depth.....

PRODUCTION

1st 24 hrs. Nat.....

1st 24 hrs. after shot.....

Gas.....Cu. Ft.

Dry Hole.....

Abandoned.....

Date

1-3-34 192 O. Mammerschlag Scout

Map No. 71 Sec. 12 Twp. 13 R. 16W

Well No. 1- Polym

Ashby Company

Contractor

COMPLETED

SECTION PLAT

330 Ft. from N. Line

..... Ft. from S. Line

330 Ft. from E. Line

..... Ft. from W. Line

QWDO

			0

Location.....

Rig up.....

Drilling and Remarks:

PB 3125
1000 acid
100 oil
20 water

RECORD

Cased..... in., ft.

Sand.....

Gas.....

Oil.....

Total Depth 3140

PRODUCTION

1st 24 hrs. Nat.....

1st 24 hrs. after shot.....

Gas..... Cu. Ft.

Dry Hole.....

Abandoned.....

Date

3/28/34 192 O. Mannschreck Scout