

Rice


FORM 51 5M 2-38 TPCO.

KANSAS

Section 8 Township 18 Range 10-W

Well No. 1 Heinz

Company C. L. Carlock et al
Huebner

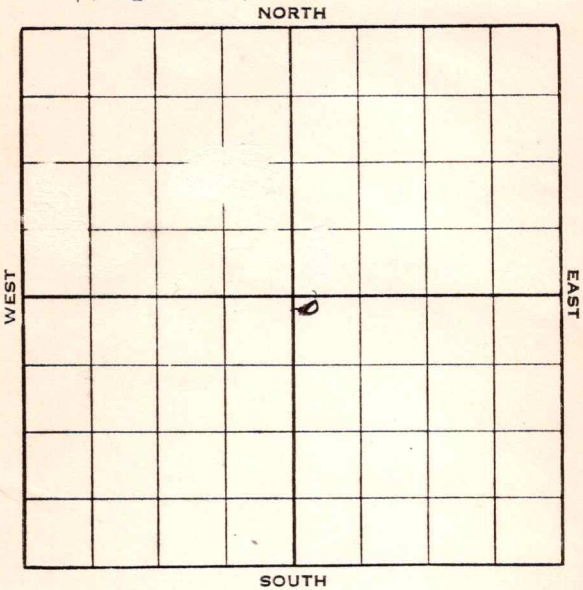

KANSAS

Rice


Sec. 8 Twp. 18 R. 10-WWell No. #1 Heinz FarmC. L. Carlock et al CompanyHuebner

O.W.W.O.

330 Ft. from N. Line

Ft. from S. Line

Ft. from E. Line

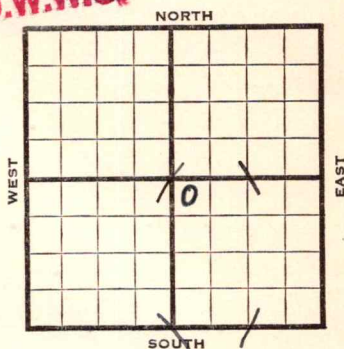330 Ft. from W. Line

Elev. 1762'

1938	REPORT
6/15	Mat'1.
6/24	B.R.R.
7/1	Anhy 470'?
	10" - 224' Drlg. 1250'
7/8	Lans. 2925'. Cored 3009-19, Recovered 2' lime porous & saturated.
7/15	7" - 2998'. RUST.
7/20	Drilled plugs Filled up 1000' oil Swab 50 bbls. oil 24 hours Gravity 42.8 at 72 Will acidize (Tel)
7/22	Drlg. plug. 1000' oil. Swab 50 oil in 24 hrs. Acidizing.
7/23	Acidized 5000 gallons Flowed 205 bbls. 1st 4 hrs. and flowed 186 bbls. 2nd 4 hours 24 hour potential 1118 bbls. (Tel)
	OVER

1938

7/27 7" - 2998'.

Lans. 2925'.

T. D. 3019'.

5000 acid.

Flowed 205 bbls. 4 hrs. & 186

bbls. 4 hrs.

Potential 1118 bbls.

COMPLETED

O.W.W.O.

1950

Elev. 1762'

2/8

Topeka 2538' Lans. 2525'

7" @ 2999'

OTD 3019'

Completed for 1118 BOPD

Drlg. 3180'

3/22

Topeka 2538'

Lans 2525'

7"@ 2999'

Arb. 3230-40 TD

TD 3240'

5" Liner @ 3234'

8 BOPH

Comp 60 BOPD

Comp

COMPLETED

Map No. _____ Sec. 8 Twp. 18 R. 10W

Well No. 1 Heinz

Huebner Company

Was Carlock Contractor

NW NW SE

El. 1762

SECTION PLAT


O.W.W.O.

330 Ft. from N. Line

_____ Ft. from S. Line

_____ Ft. from E. Line

330 Ft. from W. Line

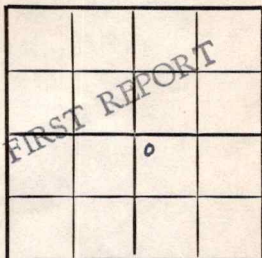

Rice County

RECORD

Location _____

Cased _____ in., _____ ft.

Rig up _____

Sand _____

Drilling and Remarks:

Gas _____

Topeka 2538

Oil _____

Lans. 2525

Total Depth _____

7" @ 2999

OTD 3019

Completed for

1118 BOPD

drlg. 3180

PRODUCTION

1st 24 hrs. Nat. _____

1st 24 hrs. after shot _____

Gas _____ Cu. Ft.

Dry Hole _____

Abandoned _____

Date

FEB 8 1950

19

J. E. TYRA

Scout

Map No. _____ Sec. 8 Twp. 18 R. 10WWell No. 1 HeinzHuebner

Company

Contractor

NW NW SE


E1. 1762

SECTION PLAT

330 Ft. from N. Line

_____ Ft. from S. Line

_____ Ft. from E. Line

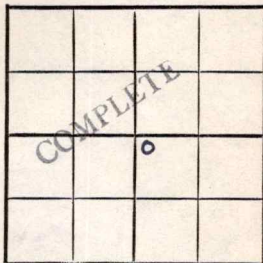330 Ft. from W. LineRice County

Location _____

Rig up _____

Drilling and Remarks:

2opeka 2538
2ans. 2525
7" @ 2999
arb 3230 - 40 T.D.
5" liner C 3234
8 baph
Comp. 60 baph

RECORD

Cased _____ in., _____ ft.

Sand _____

Gas _____

Oil _____

Total Depth _____

PRODUCTION

1st 24 hrs. Nat. _____

1st 24 hrs. after shot _____

Gas _____ Cu. Ft.

Dry Hole _____

Abandoned _____

Date

MAR 22 1950 19J. E. TYRA

Scout