

Ellis

Section 12 Township 13 Range 16 W

Well No. # 1 Polyon

Company W. F. Weigel et al

NORTH

14

WEST

EAST

SOUTH


0

Sec. 12 Twp. Ellis 13 R. 16W

Well No. #1 Polyon Farm
W. F. Weigel et al Company

Strain Drlg. Contractor
Wildcat

 Ft. from N. Line
990 Ft. from S. Line
330 Ft. from E. Line
 Ft. from W. Line

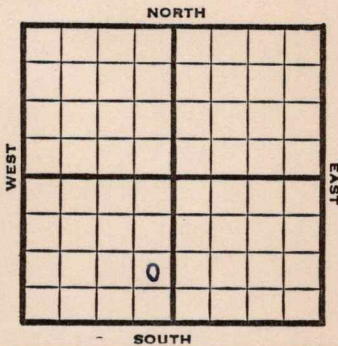

NE SE SW

1953 ^Elev. 1905' KB REPORT

4/29

Spud 4-14-53
D&A
TD 3400'
8" @ 170
Anhy 984, Top 2777
DST 2990-3030, opn 1 hr., rec. 75'
socmsw, 885#
Heeb 3035, KC 3085
DST 3103-60, opn 1 hr., 40 mins.,
rec. 90' socsw, 675#
Marm 3329, Cong 3660
TD 3400
D&A

FIRST REPORT
+
ABANDONED

County Ellis State Kansas

Sec. 12 (Blk. 13 (Sur. 16W (Twp. Rge.) Map No.

Operator W. F. Weigel et al.

Well No. 1 Farm Polygon

Elev. 1905 KB Location NE SE SW

FIRST REPORT

ABANDONED

o

990 Ft. From S Line SW

330 Ft. From E Line Quarter

1st. Report APR 29 1953

Completion APR 29 1953

Remarks

Strain Drlg. - Contr.

Spudding Date 4-14-53

Drlg. Data D & A TD 3400 Wildcat

8" @ 170 Anhy 984 Top. 2777 DST 2990-

3030 open 1 hr. Rec. 75' socmsw 885#

Heeb. 3035 KC 3085 DST 3103-60

open 1 hr. 40 min. Rec. 90' socsw 675#

Marm. 3329 Cong. 3660 TD 3400

D & A