

Map No. _____ Sec. 20 Twp. 27 R. 6Well No. 1 State Bank Leon Farm
White Eagle Co R. Company

NORTH

200 Ft. from N. Line


_____ Ft. from S. Line

_____ Ft. from E. Line

200 Ft. from W. Line

WEST

EAST

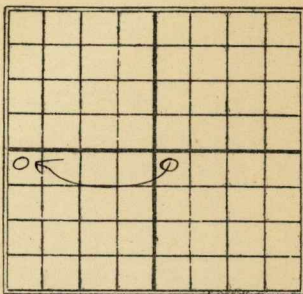

SOUTH

Date

REPORT

1/9/22

1/15 Roy.

2/4 Hely 1150'

3/26 Top sand 2688. Top Pay
2689.-2722. T.D. 2726.
Shot 40 qts. Pumping 125
Bbls.

Map No. K11 Sec. 20 Twp. 27 R. 6
 Well No. State Bank Lion
White Eagle City Ref. Company.
200' from N. NORTH 200' from W.

WEST EAST

SOUTH

Trust Report

Location.....

Rig up.....

Drilling and Remarks:

R.O. G.

RECORD

Cased..... in.,..... ft.

Sand.....

Gas.....

Oil.....

Total Depth.....

PRODUCTION

1st 24 hrs. Nat.....

1st 24 hrs. after shot.....

Gas..... Cu. Ft.

Dry Hole.....

Abandoned.....

State.....

Date *1/15* 192*2* *M.C.*

Scout

Map No. K11 Sec. 20 Twp. 27 R. 6Well No. 1 Leon State TankWhite Eagle O. & Ref. Company

Contractor

COMPLETED SECTION PLAT

200 Ft. from N. Line

Ft. from S. Line

Ft. from E. Line

200 Ft. from W. Line

This is correct

0			

Location

Rig up

Drilling and Remarks:

Try 2688, 2689, 2722
T.D. 2726
shot 40 gts.
pumping
125 lbs.

RECORD

Cased _____ in., _____ ft.

Sand _____

Gas _____

Oil _____

Total Depth _____

PRODUCTION

1st 24 hrs. Nat. _____

1st 24 hrs. after shot _____

Gas _____ Cu. Ft.

Dry Hole _____

Abandoned _____

Date


MAR 26 1922

191

M. A. BENEAR

Scout

1st. Report shows this
 300' from N. & W. in 28 1/4
 Which is correct?

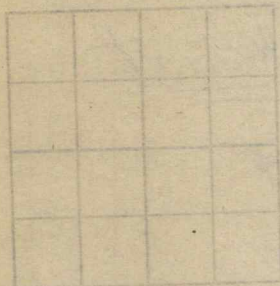

RECORD

Returned J. P. P.
 Cards P
 Tracing Sm
 J. S. C. map 5
 Frantz map 5
 Moody map 5
 Frantz plat book 5
 Moody plat book 5