


Section 12 Township 13 Range 16W

Well No. #4 Schmidt

Company Solar Oil

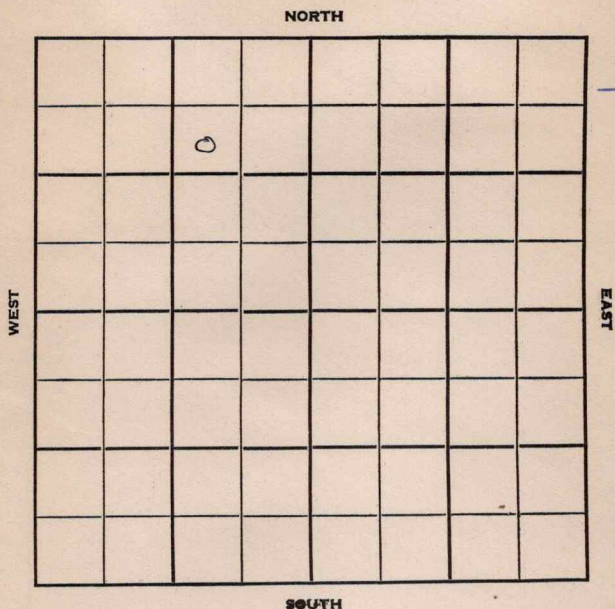

Ellis

KANSAS

Sec. 12 Twp. 13 R. 16W ☒

Well No. #4 Schmidt (Mary 'B') Farm

Solar Oil Company

Pickrell Drlg. - Contr. Contractor

Fairport Pool


990' Ft. from N. Line

 Ft. from S. Line

990' Ft. from E. Line

 Ft. from W. Line

SW NE NW

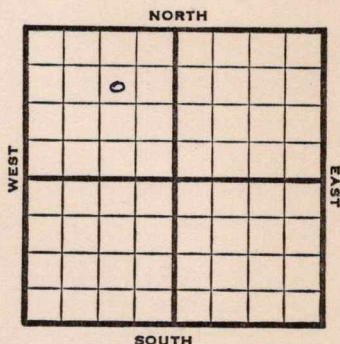

1951

Elev. 1930' REPORT

9/5

Spud 8-29-51

8" @ 1019

Drlg. 2370

9/19

Spud 8-29-51

D & A TD 3413' 8" @ 1019'

Anhy 1009'

DST 2537-45 open 1 hr. rec 170' SW

Heeb 3031' Lans. 3082'

DST 3104-14 open 1 hr. rec 15' mud

DST 3352-59 open 1 hr. rec 12' mud

Arb. 3350' TD 3413'

D & A

ABANDONED

J. E. TYRA

County Ellis State KansasSec. 12 (Blk.
Twp.) 13 (Sur.
Rge.) 16W Map No.Operator Solar OilWell No. 4 Farm SchmidtElev. 1930 Location SW NE NW990 Ft. From N Line NW990 Ft. From E Line Quarter1st. ReportCompletion SEP 19 1951Remarks Fairport PoolPickrell Drlg. - Contr.Spudding Date 8-29-51Drlg. Data D & A TD 34138" @ 1019 Anhy 1009 DST 2537-56open 1 hr. Rec. 170' sw Heeb. 3031Lans. 3082 DST 3104-14 open 1 hr.Rec. 15' mud DST 3352-59 open 1 hr.Rec. 12' mud Arb. 3350 TD 3413D & A

J. E. TYRA

021045

O.W.W.O.

14

S-513-A

CO. Ellis ELEV. 1930DF
SEC. 12 TWP. 13 RGE. 16W
COMPANY Solar Oil Co. NO. 4

CO.			
SEC.			
TWP.			
RGE.			

COMPLETE

FIRST REPORT

FARM Schmitt "B"

(O.W.W.O.)

LOC. SW NE NW

O.W.W.O.

GEOL. _____

CONTR. _____

POOL Fairport

SPUD _____

OLD INFO: spud 8/29/51

Lans. 3082, Arb. 3350,

OTD 3412, was D & A

9/19/51.

NEW INFO: MIRT DD TD

3421, 5" @ 3410 w/125,

CO 3355, perf 45/3112-3128, 1000A Pop, P
10 BOPD & 5 BWPD from Lans. 3112-28.

COMPLETE

CO.

LSE.

NO.

SEC.

TWP.

RGE.