


Map No. _____ Sec. 20 Twp. 27 R. 6
Well No. 2 Leon State Bank Farm _____
White Eagle Company _____

NORTH

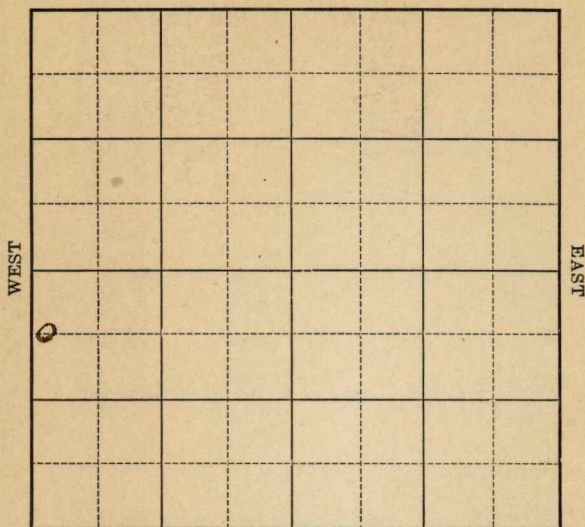

SOUTH

Rig Up-----

Drilling Remarks:

RECORD

Cased _____ in. _____ ft.

Sand _____

Gas _____

Oil _____

Total Depth -----

PRODUCTION

1st 24 hrs. Nat. -----

1st 24 hrs. after shot-----

Gas _____ cu. ft.

Dry Hole_____

Abandoned-----


Map No. _____ Sec. 20 Twp. 27 R. 6
 Well No. #2 Leon State Bank Farm
White Eagle Company

660 Ft. from N. Line

_____ Ft. from S. Line

_____ Ft. from E. Line

200 Ft. from W. Line

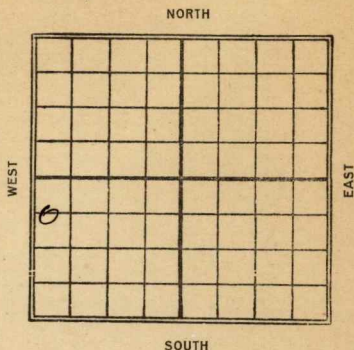

Date

REPORT

1924

7/15

1924

7/16

Rig
 Top. S. 2690-2708-

J.D. 2716'

40/50'

Map No. Gas 11 Sec. 20 Twp. 27 R. 6
 Well No. 2 Leap State Bank
White Eagle Company
 Contractor

FIRST REPORT

SECTION PLAT

660 Ft. from N. Line
 _____ Ft. from S. Line
 _____ Ft. from E. Line
200 Ft. from W. Line

0			

Location _____

Rig up _____

Drilling and Remarks:

Rig

RECORD

Cased _____ in., _____ ft.

Sand _____

Gas _____

Oil _____

Total Depth _____

PRODUCTION

1st 24 hrs. Nat. _____

1st 24 hrs. after shot _____

Gas _____ Cu. Ft.

Dry Hole _____

Abandoned _____

Date

JUL 15 1922

191

M. A. BENEAR Scout

Map No. 11 Kans 20 Sec. 20 Twp. 27 R. 6Well No. Leaw state Bank
White Eagle Oil Company

Contractor

COMPLETED

SECTION PLAT

660 Ft. from N. Line

Ft. from S. Line

Ft. from E. Line

200 Ft. from W. Line

0			

Location

Rig up

Drilling and Remarks:

Tap 1, 2690-2708J.D. 271640/50

RECORD

Cased _____ in., _____ ft.

Sand _____

Gas _____

Oil _____

Total Depth _____

PRODUCTION

1st 24 hrs. Nat. _____

1st 24 hrs. after shot _____

Gas _____ Cu. Ft.

Dry Hole _____

Abandoned _____

Date

M.A.B. 7/23/24
192 Scout