


Kansas

Map No. _____ Sec. 20 Twp. 27 R. 6
Well No. 3 Leon State Bank Farm _____
White Eagle Company _____

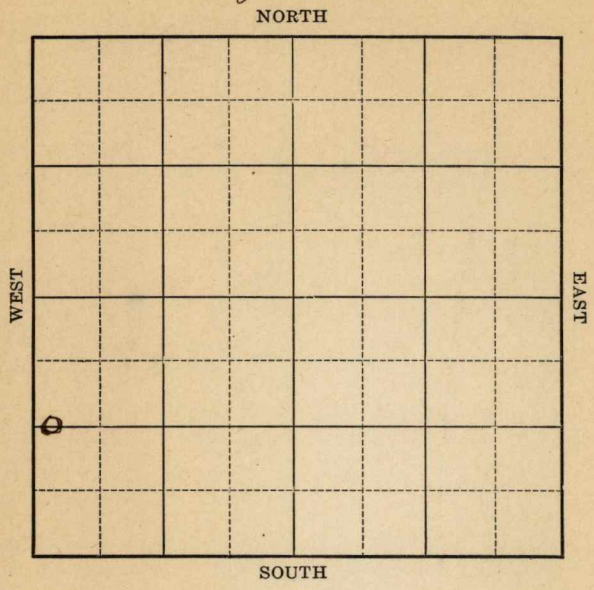

Location _____
Drilling Remarks: _____

Rig Up _____
Drilling Remarks: _____

RECORD

Cased _____ in. _____ ft.
Sand _____
Gas _____
Oil _____
Total Depth _____

PRODUCTION

1st 24 hrs. Nat. _____
1st 24 hrs. after shot _____
Gas _____ cu. ft.
Dry Hole _____
Abandoned _____


Map No. _____ Sec. 20 Twp. 27 R. 6
Well No. #3 Leon State Bank Farm
White Eagle Company

_____ Ft. from N. Line

1320 Ft. from S. Line

Ft. from E. Line

200 Ft. from W. Line

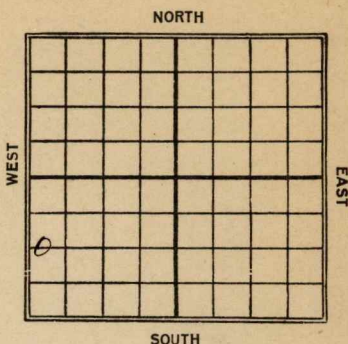[illegible]

Map No. Kans 11 20 Sec. 27 R. 6Well No. 3 Leon State bankWhite Eagle Company

Contractor

FIRST REPORT

SECTION PLAT

Ft. from N. Line

1320 Ft. from S. Line

Ft. from E. Line

200 Ft. from W. Line

Location

Rig up

Drilling and Remarks:

Truifer

RECORD

Cased _____ in., _____ ft.

Sand _____

Gas _____

Oil _____

Total Depth _____

PRODUCTION

1st 24 hrs. Nat. _____

1st 24 hrs. after shot _____

Gas _____ Cu. Ft.

Dry Hole _____

Abandoned _____

Date

JUL 22 1922

191

M. A. BENEAR

Scout

Map No. **KANSAS** 11 Sec. **20** Twp. **27** R. **6**
 Well No. **3 Leon State Bank**
White Eagle Company
 Contractor

COMPLETED SECTION PLAT

----- Ft. from N. Line
1320' Ft. from S. Line
 ----- Ft. from E. Line
200' Ft. from W. Line

①			

Location -----
 Rig up -----
 Drilling and Remarks:

shot 40 qt

RECORD

Cased ----- in., ----- ft.
 Sand -----
 Gas -----
 Oil **2702 - 2723**
 Total Depth **2723**

PRODUCTION

1st 24 hrs. Nat. -----
 1st 24 hrs. after shot **15**
 Gas ----- Cu. Ft.
 Dry Hole -----
 Abandoned -----

Date

JAN 6 1923

M. A. BENEAR

191

Scout