

Kansas

Map No. **KANSAS** Sec. 21 Twp. 27 R. 6

Well No. 1 Brown Farm
Elburn Oil Company
Blakeslee NORTH wentz

WEST								EAST
	0							
SOUTH								

FIRST REPORT

Location _____

Drilling Remarks: _____

RECORD

Cased _____ in. _____ ft.

Sand _____

Gas _____

Oil _____

Total Depth _____

Rig Up _____

Drilling Remarks: _____

PRODUCTION

1st 24 hrs. Nat. _____

1st 24 hrs. after shot _____

Gas _____ cu. ft.

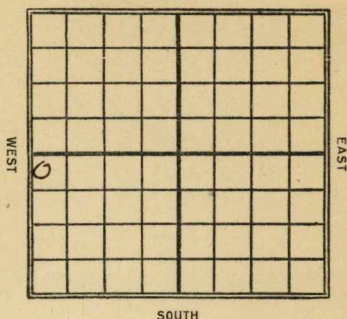
Dry Hole _____

Abandoned _____

Map No. **KANSAS** Sec. 21 Twp. 27 R. 6Well No. 1 Brown Farm
Elburn Oil Company
Blakeslee & Stentz200 Ft. from N. Line

Ft. from S. Line

Ft. from E. Line

200 Ft. from W. Line

Date	REPORT
1922	
10/26	Rig.
4/7	D.D.A. 2840'
1927	O.W.D.D.
12/7	Rign up
12/14	T.D. 2840' - Rigging up
12/21	C.D. @ 2400-
12/19	S.D. 2790-
1928	
1/5	Top line 2710- S.D. 2790-
1/11	—
1/18	—
1/26	—
2/2	—
2/9	Base line 3000- drelg 3010-
2/16	S.D. 3041
2/23	Top line 2710-3000-Base Wilcoe 3073-77-H.F.W L. & A. 3077
3/1	Top line 2710-3000 Wilcoe 3073-77 Sile. line 3121-36 L. & A. 3136-H.F.W

Map No. **KANSAS** Sec. 21 Twp. 27 R. 6

Well No. 1 Brown

E. E. Eubank Company

Contractor

ABANDONED

SECTION PLAT

200 Ft. from N. Line

_____ Ft. from S. Line

_____ Ft. from E. Line

200 Ft. from W. Line

Location _____

Rig up _____

Drilling and Remarks:

4 1/2
2840'

RECORD

Cased _____ in., _____ ft.

Sand _____

Gas _____

Oil _____

Total Depth _____

PRODUCTION

1st 24 hrs. Nat. _____

1st 24 hrs. after shot _____

Gas _____ Cu. Ft.

Dry Hole _____

Abandoned _____

Date APR 7 1923

M. A. BENEAR

_____ 191 _____ Scout