


Section 19 Township 13 Range 16W

Well No. #1 Margaret

Company Gulf

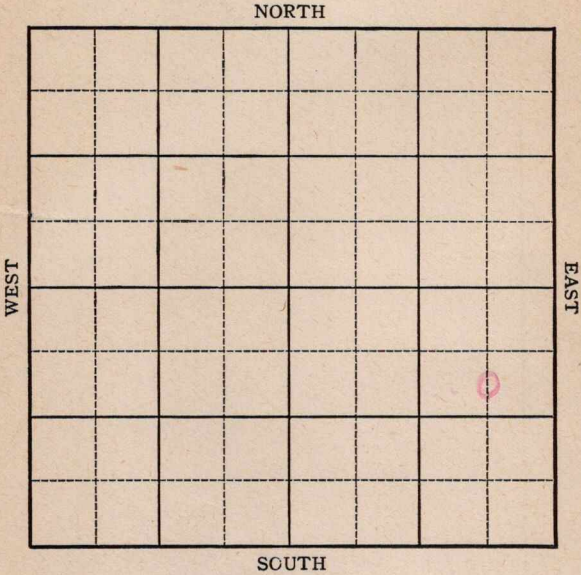

Sec. 19 **KANSAS** Twp. 13 R. 16W


Well No. #1 Margaret Farm _____
Gulf Company _____

990 Ft. from N. Line

_____ Ft. from S. Line

660 Ft. from E. Line

_____ Ft. from W. Line

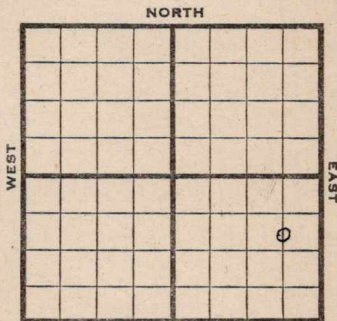

CSL NE SE *Ellis. 1979*

1945 R E P O R T

3/14	8" @ 1126 Anhy 1130 WOC
3/23	Drlg. 2945'
3/29	Lans 3262 Arb 3509 TD 3512 SO 5" @ 3510' RUST
4/5	3514-8 gals. oil PH 1000 acid.
4/12	5000 acid. No help TD 3527 300' wtr. 3 hrs.
4/20	PB 3495
4/26	PB 3520 48 shots 3512-3519 5000 acid. 18' of 4 1/2" liner @ 3520 72 shots 3512-3520
5/3	Pump 7 oil in 17 hrs.
5/10	" " " " "
5/17	" " " " "
5/24	" " " " "
5/31	" " " " "
6/8	" " " " "
6/14	" " " " "
6/21	" " " " "
6/28	" " " " "
7/3	" " " " "
7/11	" " " " "
7/19	" " " " "
7/26	" " " " "

OVER

740215

1945

8/1

Arb. 3509

5" @ 3510'

T.D. 3527'

5000 acid

Pump 6 pot.

Gravity 28

COMPLETED

Pool Name NO NAME

Map No. 71 Sec. 19 Twp. 13 R. 16W

Well No. 1 Margaret

Gulf Company

FIRST REPORT Contractor

C S L NE SE

SECTION PLAT

990 Ft. from N. Line

_____ Ft. from S. Line

660 Ft. from E. Line

_____ Ft. from W. Line

Ellis

Location _____

Rig up _____

Drilling and Remarks:

8" - 1126

anhy 1130 WOC

RECORD

Cased _____ in., _____ ft.

Sand _____

Gas _____

Oil _____

Total Depth _____

PRODUCTION

1st 24 hrs. Nat. _____

1st 24 hrs. after shot _____

Gas _____ Cu. Ft.

Dry Hole _____

Abandoned _____

Date

MAR 14 1945 19 _____

S. J. LEWIS

Scout

KANSAS Kansas

Pool Name Herzog

Map No. 71 Sec. 19 Twp. 13 R. 16W

Well No. 1 Margaret

Gulf Company

COMPLETED

Contractor

C S L NE SE

E. 11998
SECTION PLAT

990 Ft. from N. Line

 Ft. from S. Line

660 Ft. from E. Line

 Ft. from W. Line

			<i>d</i>

Ellis County

Location

Rig up

Drilling and Remarks:

Art 3509
5" @ 3510
5000 cu ft
Pump 6 R & Y

28 2/3

RECORD

Cased in., ft.

Sand

Gas

Oil

Total Depth 3520

PRODUCTION

1st 24 hrs. Nat.

1st 24 hrs. after shot

Gas Cu. Ft.

Dry Hole

Abandoned

Date

AUG 1 1945 19

S. J. LEWIS Scout