


Section 22 Township 23 Range 13E

Well No. 14  
~~#17~~ Lovitt

Company R.E. French

*Kelly Oil - K65  
DRL*

NORTH

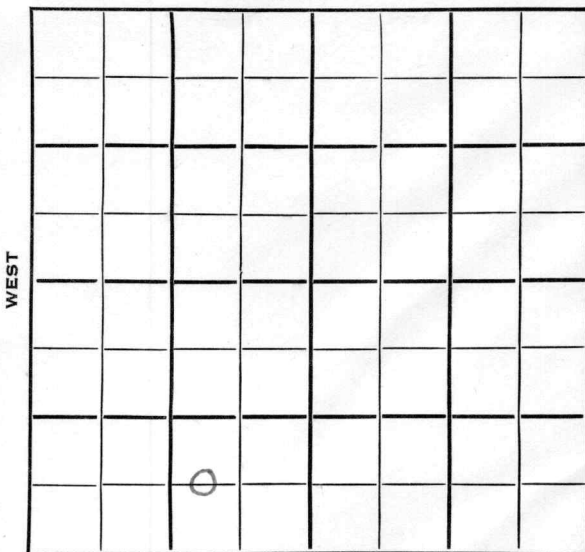

SOUTH

Greenwood KANSAS ✓

Sec. 22 Twp. 23 R. 13E

Well No. #14 ~~71~~ Lovitt Farm

Kelly O.I.  
R. E. French Company

Brown Drlg. Contractor


N. Virgil Pool

Ft. from N. Line

660 Ft. from S. Line

990 Ft. from E. Line

Ft. from W. Line

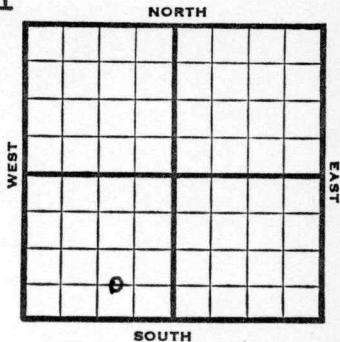

C W L SE SW

1953

Elev. -

REPORT

4/29

RUCT

7/1

Spud ~~51~~-53  
 Oil Well  
 TD 1619  
 13" @ 468  
 10" @ 879  
 8" @ 1410  
 Bart 1585  
 7" @ 1586  
 DD 1619  
 FU 425' oil 16 hrs.  
 Comp. 20 bopd 10 bw



KANSAS

Map No. \_\_\_\_\_ Sec. 22 Twp. 23 R. 13E

Well No. 14 Lovitt

Kelly Oil Company

**CORRECTION**

Contractor \_\_\_\_\_

C W L SE SW

**SECTION PLAT**

\_\_\_\_\_ Ft. from N. Line

660 Ft. from S. Line

990 Ft. from E. Line

\_\_\_\_\_ Ft. from W. Line

	6		

Greenwood County

Location \_\_\_\_\_

Rig up \_\_\_\_\_

Drilling and Remarks:

Reported  
R. E. French  
#1 Lovitt

**RECORD**

Cased \_\_\_\_\_ in., \_\_\_\_\_ ft.

Sand \_\_\_\_\_

Gas \_\_\_\_\_

Oil \_\_\_\_\_

Total Depth \_\_\_\_\_

**PRODUCTION**

1st 24 hrs. Nat. \_\_\_\_\_

1st 24 hrs. after shot \_\_\_\_\_

Gas \_\_\_\_\_ Cu. Ft.

Dry Hole \_\_\_\_\_

Abandoned \_\_\_\_\_

Date

MAY 13 1953

**J. G. McGEHEE**

Scout

County Greenwood State Kansas

Sec. 22 (Blk. 23) (Sur. 13E) Map No.

Operator Kelly Oil

Well No. 14 Farm Lovitt

Elev. \_\_\_\_\_ Location C W L SE SW


**COMPLETE**

660 Ft. From S Line SW

990 Ft. From E Line Quarter

1st. Report

Completion JUL 1 1953

Remarks N. Virgil Pool

Brown Drlg. - Contr.

Spudding Date 5-1-53

Drlg. Data Oil well TD 1619

13" @ 468 10" @ 879 8" @ 1410

Bart. 1585 7" @ 1586 DD 1619

FU 425 ' oil 16 hr.

Comp. 20 bopd 10 bw

J. G. MCGHEE