


Section 19 Township 13 Range 16W

Well No. #1 A.G. Dreiling


Company Gulf

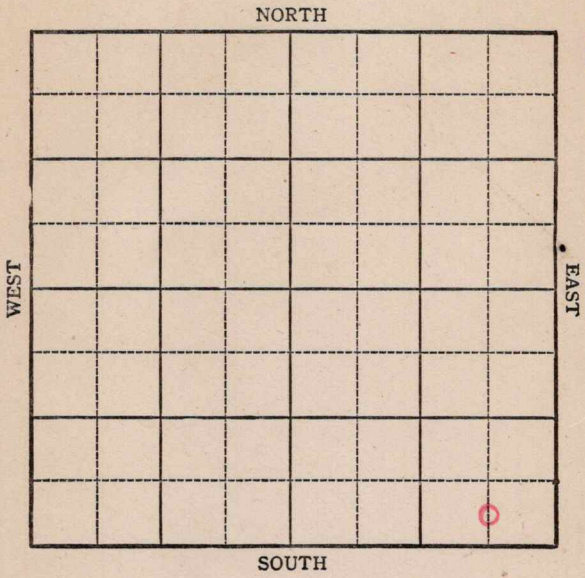

Sec. 19 Twp. 13 R. 16W

Well No. #1 A.G. Dreiling Farm \_\_\_\_\_  
 Gulf \_\_\_\_\_ Company \_\_\_\_\_  
 Wildcat

\_\_\_\_\_ Ft. from N. Line  
330 Ft. from S. Line  
660 Ft. from E. Line  
 \_\_\_\_\_ Ft. from W. Line

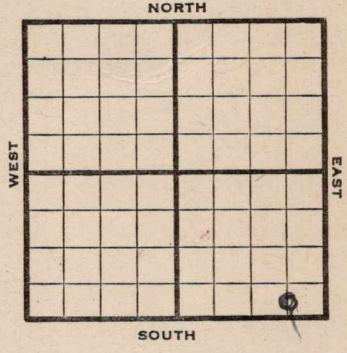

CSL SE SE

1945 R E P O R T

2/7	R U R
2/14	8" @ 1114 Anhy 1123 WOC
2/21	Drlg 3035
2/28	Lans 3246 Arb 3487 $\frac{1}{2}$ - 89 TD 5" @ 3488 RUST
3/7	Swb 204 oil in 12 hrs
3/14	TD 3493 Swab 53 oil in 3 hrs 1000 acid
3/23	" " " " " "
3/29	" " " " " "
4/4	Arb 3487 $\frac{1}{2}$ 5 $\frac{1}{2}$ " @ 3488 1000 acid. TD 3493 Depth Pot. 2453 Grav. 36.2

**COMPLETED**

Pool Name Wildcat

**KANSAS**

Map No. K7 | Sec. 19 Twp. 13 R. 16W

Well No. 1 A. G. Drilling

Gulf Company

FIRST REPORT Contractor

C S L S E S E

**SECTION PLAT**

			o

         Ft. from N. Line

330 Ft. from S. Line

660 Ft. from E. Line

         Ft. from W. Line

Ellis

Location         

Rig up         

Drilling and Remarks:

R U R

**RECORD**

Cased          in.,          ft.

Sand         

Gas         

Oil         

Total Depth         

**PRODUCTION**

1st 24 hrs. Nat.         

1st 24 hrs. after shot         

Gas          Cu. Ft.

Dry Hole         

Abandoned         

Date

FEB 7 1945 19

S. J. LEWIS Scout

