


Map No. 22 Sec. 22 Twp. 23 R. 13
 Well No. Long McNeal Farm
Daily Street Company
OKO OIL CO.

NORTH

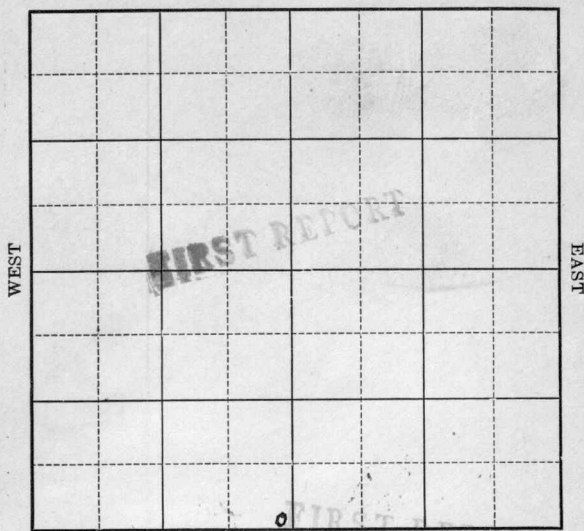

O. W. D. D

SOUTH

Location

Drilling Remarks:

Rig Up

Drilling Remarks:

RECORD

Cased in. ft.

Sand

Gas

Oil

Total Depth

PRODUCTION

1st 24 hrs. Nat.

1st 24 hrs. after shot

Gas cu. ft.

Dry Hole

Abandoned


Map No. _____ Sec. 22 Twp. 23 R. 13Well No. 1 Lovett & McNeil Farm
Shady St. at. Company
OKO OIL

____ Ft. from N. Line

250~~250~~ Ft. from S. Line250~~250~~ Ft. from E. Line

____ Ft. from W. Line

O. W. D. D

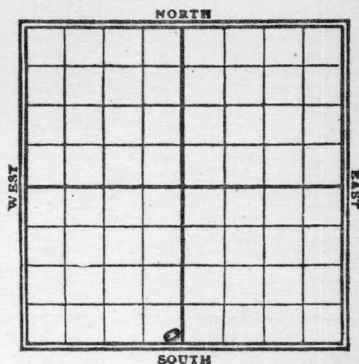

Date	REPORT
1920	
9/3	<u>Reg up</u>
9/11	<u>is</u>
9/15	<u>-</u>
23	<u>Dly @ 300'</u>
30	<u>375'</u>
11/3	<u>Land 1594-1618- F.D. 1622</u>
	<u>drilled this well 4'</u>
	<u>into water trying</u>
	<u>to plug off sand</u>
1921	
1/20	<u>1594-1618- F.D. 1622</u>
	<u>4' water sand- Plugged</u>
	<u>back. 1618- shot</u>
	<u>80 gts / 30 lbs oil</u>
	<u>50 lbs water</u>
1935	
	O. W. D. D
6/5	<u>TML 1726 Pay 1733-65 T1</u>
	<u>60 gts. 25 lbs.</u>
	11-12-17
	FIRST REPORT
	COMPLETED

Map No. No Map Sec. 22 Twp. 23 R. 13

Well No. 1 Lovett & M. E. Neil

Darby et al Company

Contractor

SECTION PLAT



----- Ft. from N. Line

200 ----- Ft. from S. Line

200 ----- Ft. from E. Line

----- Ft. from W. Line

Location -----

Rig up ☒ -----

Drilling and Remarks:

RECORD

Cased ----- in., ----- ft.

Sand -----

Gas -----

Oil -----

Total Depth -----

PRODUCTION

1st 24 hrs. Nat. -----

1st 24 hrs. after shot -----

Gas ----- Cu. Ft.

Dry Hole -----

Abandoned -----

Date

Pyle

9/3 1920

Scout

Map No. K17 Sec. 22 Twp. 23 R. 13Well No. 1 Lovett & McNeilDarby et al Company

Contractor

SECTION PLAT

-----Ft. from N. Line

-----Ft. from S. Line

-----Ft. from E. Line

-----Ft. from W. Line

COMPLETED

Location -----

Rig up -----

Drilling and Remarks:

Total 1622 loss
4 ft water sand
Plugged back to
1618.

Shot 80 gts

Date

30 bbls oil, 50 bbls water

RECORD

Cased ----- in., ----- ft.

Sand 1594 - 1618

Gas -----

Oil -----

Total Depth -----

PRODUCTION

1st 24 hrs. Nat. -----

1st 24 hrs. after shot -----

Gas ----- Cu. Ft.

Dry Hole -----

Abandoned -----

Pyle

Map No. 17 Sec. 22 Twp. 23 R. 13EWell No. 1- Lovett & M^cNealOk oil

Company

Contractor

FIRST REPORTS

SECTION PLAT

correct company name
correct feet measurements

Ft. from N. Line

250 Ft. from S. Line250 Ft. from E. Line

Ft. from W. Line

CORRECTION

No not have record ofLocation old well.

Rig up

Drilling and Remarks:

OTU 1631T.M.L. 1726pay 1733-6560 qts25 bbls

RECORD

Cased.....in.,ft.

Sand.....

Gas.....

Oil.....

Total Depth 1765

PRODUCTION

1st 24 hrs. Nat.....

1st 24 hrs. after shot.....

Gas.....Cu. Ft.

Dry Hole.....

Abandoned.....

Date

6-5-35

192.....

Scout

ORVAL MANNSCHRECK