


KANSAS

Ellis county

Section 20 Township 13 Range 16W

Well No. #1, Dreiling

Company Wondra & Carsten

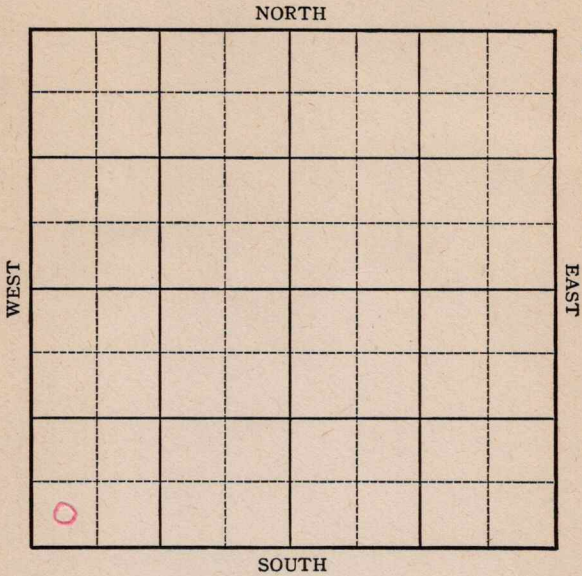

KANSAS

Ellis County

Sec. 20 Twp. 13 R. 16W

Well No. #1 Dreiling Farm  
Wondra & Carsten Company

Herzog


Ft. from N. Line

330 Ft. from S. Line

Ft. from E. Line

330 Ft. from W. Line

SW/c

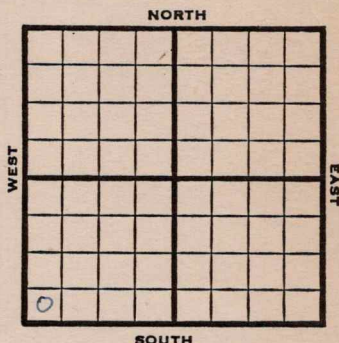

1946 Elev 1968' REPORT

4/3 Anhy. 1112  
8" @ 1118  
Drlg. 2 615'

4/10 Topeka 2955  
Lans 3290  
Arb 3485-90 TD  
5" @ 3486; RUST

4/16 TD 3496 1000 acid  
Pump 30 oil 1 hr

4/23 1000 acid

5/1 " "

5/7 " "

5/14 " "

5/21 " "

5/29 " "

6/5 " "

6/19 Arb 3485'  
5" @ 3486'  
1000 acid  
Pump 210 Pot  
38.0 Gr.  
TD 3496'

COMPLETED

**KANSAS**Kansas Pool Name HerzogMap No. 71 Sec. 20 Twp. 13 R. 16WWell No. 1 DreilingWondra & Carsten

Company

FIRST REPORT

Contractor

SW/C

## SECTION PLAT

|   |  |  |  |
|---|--|--|--|
|   |  |  |  |
|   |  |  |  |
|   |  |  |  |
|   |  |  |  |
| o |  |  |  |

       Ft. from N. Line330       Ft. from S. Line       Ft. from E. Line330       Ft. from W. LineEllis CountyLocation                                 Rig up                                 

Drilling and Remarks:

Anhy. 1112

8" @ 1118

Dr1g. 2615

## RECORD

Cased            in.,            ft.Sand                                 Gas                                 Oil                                 Total Depth                                 

## PRODUCTION

1st 24 hrs. Nat.                                 1st 24 hrs. after shot                                 Gas                                  Cu. Ft.Dry Hole                                 Abandoned                                 

Date

APR 3 194619S. J. LEWISScout

**KANSAS**Kansas Pool Name Herzog PoolMap No. 71 Sec. 20 Twp. 13 R. 16WWell No. 1 DreilingWondra & Carsten Company**COMPLETED**

Contractor

SW/C

E. 1968**SECTION PLAT**

|  |  |  |  |
|--|--|--|--|
|  |  |  |  |
|  |  |  |  |
|  |  |  |  |
|  |  |  |  |

       Ft. from N. Line330 Ft. from S. Line       Ft. from E. Line330 Ft. from W. LineEllis CountyLocation                                 Rig up                                 

Drilling and Remarks:

Per 834855" 834861000 acidPump 210 Pst38°/h**RECORD**Cased        in.,        ft.Sand                                 Gas                                 Oil                                 Total Depth 3496**PRODUCTION**1st 24 hrs. Nat.                                 1st 24 hrs. after shot                                 Gas                                  Cu. Ft.Dry Hole                                 Abandoned                                 

Date

JUN 19 1946

19

S. J. LEWIS

Scout