
Form 51—5-19—5M—Mid-West

Map No. _____ Sec. 22 Twp. 23 R. 13

Well No. 1 Lovett & McNeil Farm

Cosden etal Company

Mine Spar Oil Co

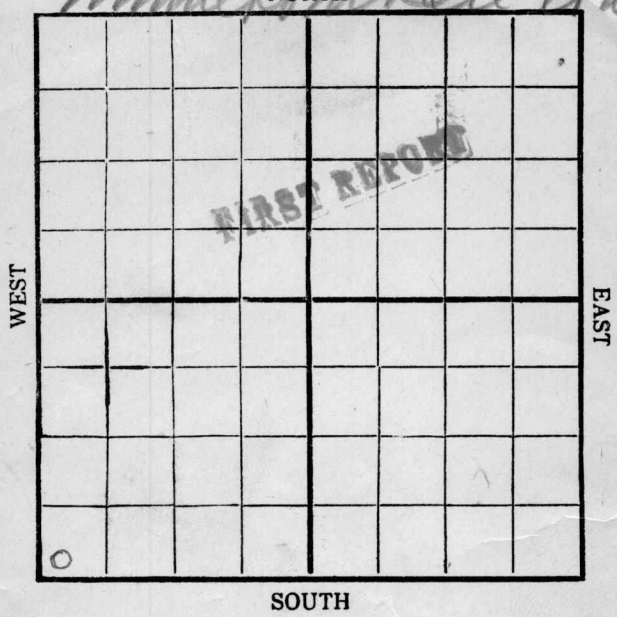

Location _____	Rig Up _____
Drilling Remarks:	Drilling Remarks:
_____	_____
_____	_____
RECORD	PRODUCTION
Cased _____ in. _____ ft.	1st 24 hrs. Nat. _____
Sand _____	1st 24 hrs. after shot _____
Gas _____	Gas _____ cu. ft.
Oil _____	Dry Hole _____
Total Depth _____	Abandoned _____

Form 26—1M—4-19—Mid-West


Map No. _____ Sec. 22 Twp. 23 R. 13

Well No. 1 Loveth & McNeil

Cooden et al Company

_____ Contractor

SECTION PLAT

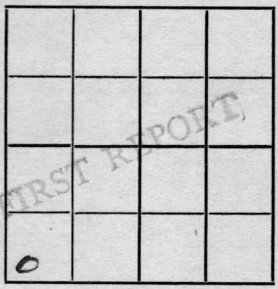

_____ Ft. from N. Line

150 Ft. from S. Line

_____ Ft. from E. Line

150 Ft. from W. Line

Location _____

Rig up _____

Drilling and Remarks:

430'

RECORD

Cased _____ in., _____ ft.

Sand _____

Gas _____

Oil _____

Total Depth _____

PRODUCTION

1st 24 hrs. Nat. _____

1st 24 hrs. after shot _____

Gas _____ Cu. Ft.

Dry Hole _____

Abandoned _____

Date

6/6/1919

Pyle Scout


Form 26—1M Books of 100 Sheets Each—4-15-18

Map No. ____ Sec. 22 Twp. 23 R. 13

Well No. 1 South McNeil

Cowden et al Company

Contractor

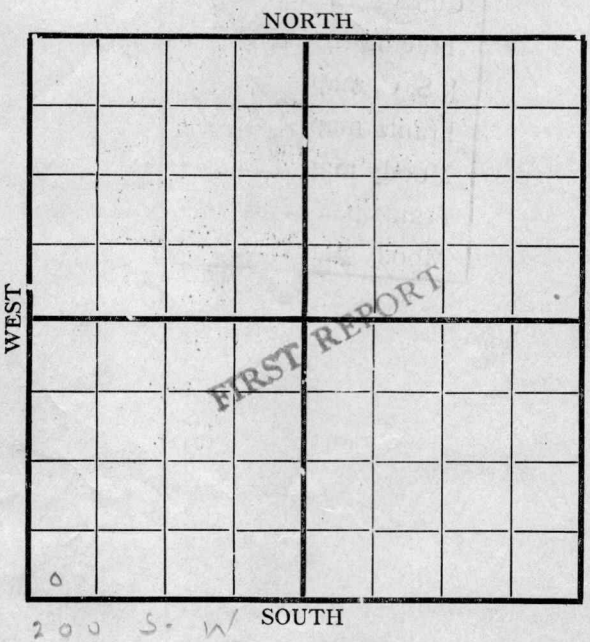

Location

Rig up

Drilling and Remarks:

430'

RECORD

Cased ____ in., ____ ft.

Sand

Gas

Oil

Total Depth

PRODUCTION

1st 24 hrs. Nat.

1st 24 hrs. after shot

Gas ____ Cu. Ft.

Dry Hole

Abandoned

Date

6/6 191 9. Clyde Scout


Form 26—1M Books of 100 Sheets Each—4-15-18

Map No. ____ Sec. 22 Twp. 23 R. 13

Well No. 1 Lovett & McNeil

Cosden et al Company

Contractor

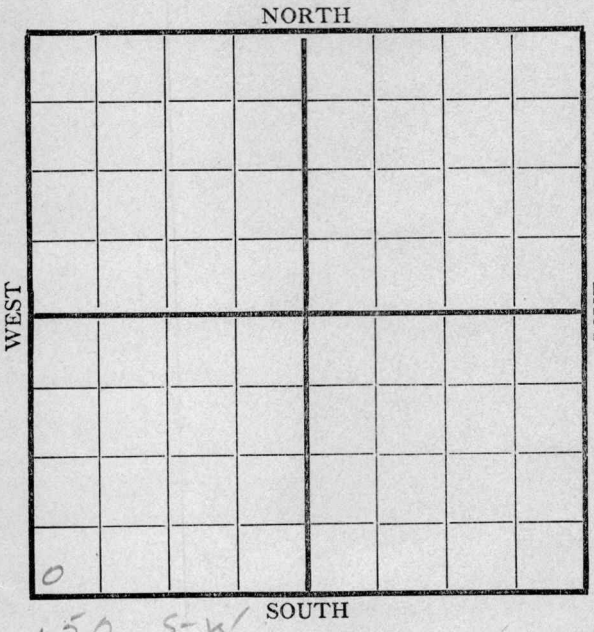

Location ____

Rig up ____

Drilling and Remarks:

450'

RECORD

Cased ____ in., ____ ft.

Sand ____

Gas ____

Oil ____

Total Depth ____

PRODUCTION

1st 24 hrs. Nat. ____

1st 24 hrs. after shot ____

Gas ____ Cu. Ft.

Dry Hole ____

Abandoned ____

Date

6/11/19

Pyle Scout

Form 26—1M—4-19—Mid-West


Map No._____ Sec. 22 Twp. 23 R. 13

Well No. 1 Lovett & McNeil

Cosden etal Company

_____ Contractor

SECTION PLAT

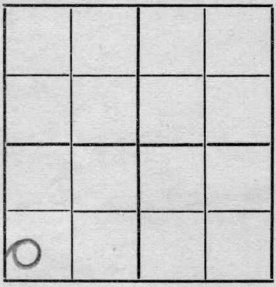

_____ Ft. from N. Line

150 Ft. from S. Line

_____ Ft. from E. Line

150 Ft. from W. Line

Location _____

Rig up _____

Drilling and Remarks:

drlg 450

6/14

RECORD

Cased _____ in., _____ ft.

Sand _____

Gas _____

Oil _____

Total Depth _____

PRODUCTION

1st 24 hrs. Nat. _____

1st 24 hrs. after shot _____

Gas _____ Cu. Ft.

Dry Hole _____

Abandoned _____

Date

6/21 191 9 Office Scout

Form 26—1M—4-19—Mid-West


Map No. ____ Sec. 22 Twp. 23 R. 13

Well No. 1 Lovell & McNeil

Michehoma Oil Company

Contractor

SECTION PLAT

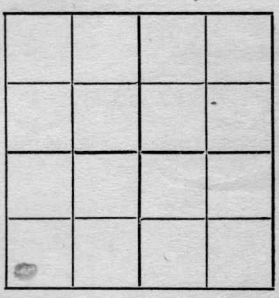

____ Ft. from N. Line

150 Ft. from S. Line

____ Ft. from E. Line

150 Ft. from W. Line

Location ____

Rig up ____

Drilling and Remarks:

Pumping off
@ 8 bbls
per day

RECORD

Cased ____ in., ____ ft.

Sand ____

Gas ____

Oil ____

Total Depth ____

PRODUCTION

1st 24 hrs. Nat. ____

1st 24 hrs. after shot ____

Gas ____ Cu. Ft.

Dry Hole ____

Abandoned ____

Date

6/27 191D

Pyle Scout


Form 26—1M Books of 100 Sheets Each—4-15-18

Map No. 1 Sec. 22 Twp. 23 R. 13

Well No. 1 Lovell Tom McNeil

Corden et al Company

Contractor

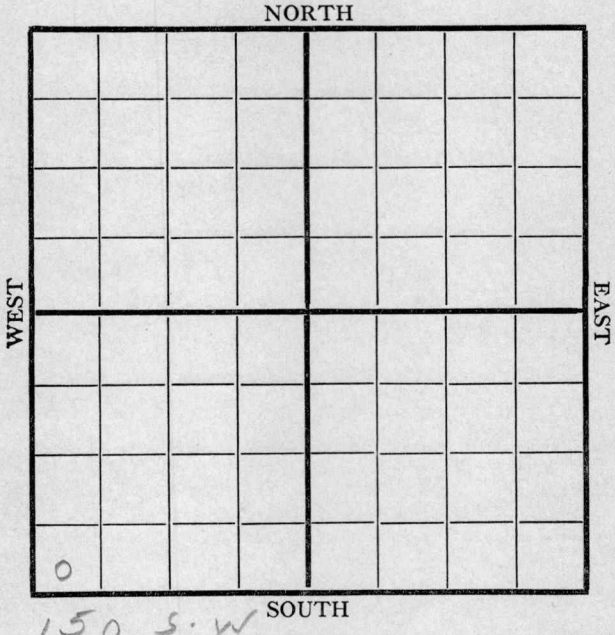

Location

Rig up

Drilling and Remarks:

810'

RECORD

Cased in., ft.

Sand

Gas

Oil

Total Depth

PRODUCTION

1st 24 hrs. Nat.

1st 24 hrs. after shot

Gas Cu. Ft.

Dry Hole

Abandoned

Date

6/27 191 9 Scout


Form 26—1M Books of 100 Sheets Each—4-15-18

Map No. ____ Sec. 22 Twp. 23 R. 13

Well No. 1 Lovell McNeil

Coolidge et al Company

Contractor

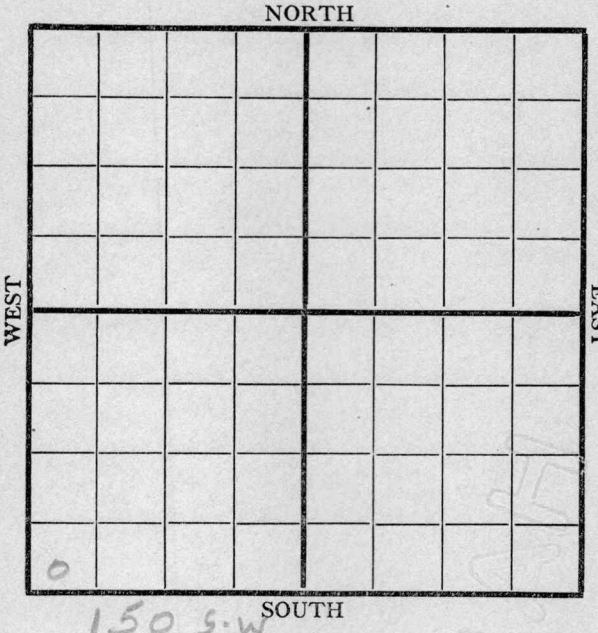

Location ____

Rig up ____

Drilling and Remarks:

8" @ 1020'

RECORD

Cased ____ in., ____ ft.

Sand ____

Gas ____

Oil ____

Total Depth ____

PRODUCTION

1st 24 hrs. Nat. ____

1st 24 hrs. after shot ____

Gas ____ Cu. Ft.

Dry Hole ____

Abandoned ____

Date

7/1 1919 Cyclone Scout


Form 26—1M Books of 100 Sheets Each—4-15-18

Map No. K Sec. 22 Twp. 23 R. 13

Well No. 1 Lovett Grp & Mail

Cowden et al Company

Contractor

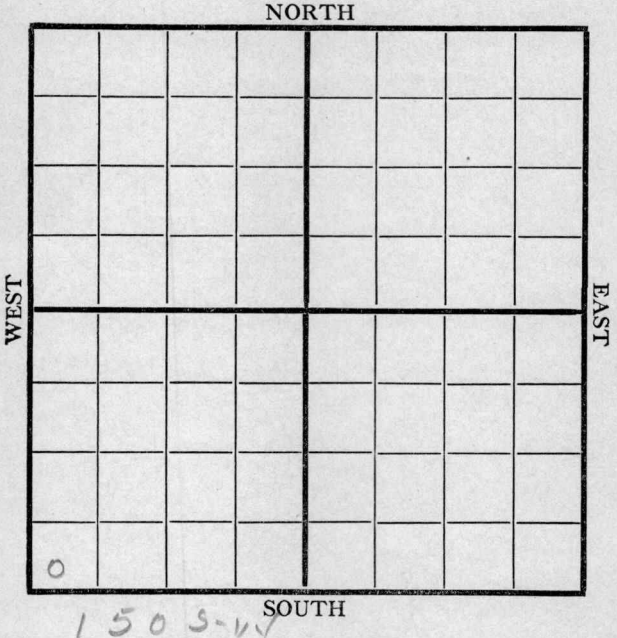

1503-W

Location

Rig up

Drilling and Remarks:

1060

H, F, W.

RECORD

Cased in., ft.

Sand

Gas

Oil

Total Depth

PRODUCTION

1st 24 hrs. Nat.

1st 24 hrs. after shot

Gas Cu. Ft.

Dry Hole

Abandoned

Date

7/12 191 9 Scout


Form 26—1M Books of 100 Sheets Each—4-15-18

Map No. K-14 Sec. 22 Twp. 23 R. 13

Well No. 1 Lovett & McNeil

Cosden et al Company

Contractor

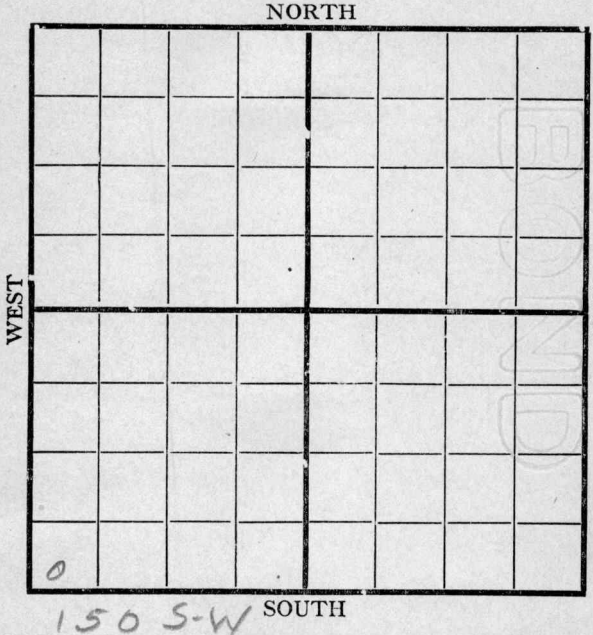

Location

Rig up

Drilling and Remarks:

21, R 8 1/4

to 1060'

RECORD

Cased in., ft.

Sand

Gas

Oil

Total Depth

PRODUCTION

1st 24 hrs. Nat.

1st 24 hrs. after shot

Gas Cu. Ft.

Dry Hole

Abandoned

Date

7/19 191 9. Cyclone Scout


Form 26—1M Books of 100 Sheets Each—4-15-18

Map No. K 14 Sec. 22 Twp. 23 R. 13

Well No. 1 Lovell & McNeil

Casden et al Company

Contractor

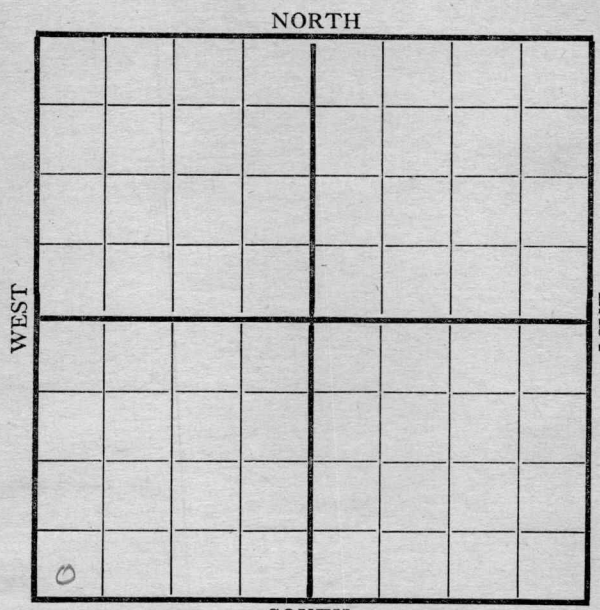

1505-W

Location

Rig up

Drilling and Remarks:

N.R. 10" to 1140

RECORD

Cased in., ft.

Sand

Gas

Oil

Total Depth

PRODUCTION

1st 24 hrs. Nat.

1st 24 hrs. after shot

Gas Cu. Ft.

Dry Hole

Abandoned

Date

7/23 191 9. Pyle Scout


Form 26—1M Books of 100 Sheets Each—4-15-18

Map No. ____ Sec. 22 Twp. 23 R. 13

Well No. 1 Lovell T. M. Neil

Cosden et al Company

Contractor

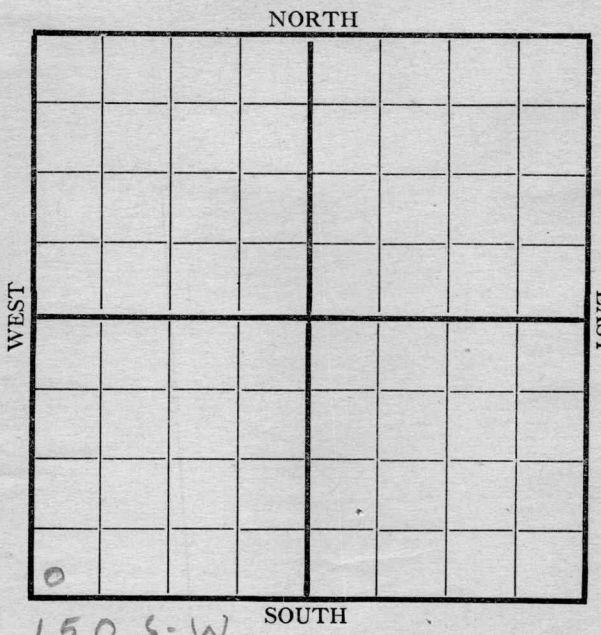

1505-W

Location

Rig up

Drilling and Remarks:

1700

RECORD

Cased ____ in., ____ ft.

Sand

Gas

Oil

Total Depth

PRODUCTION

1st 24 hrs. Nat.

1st 24 hrs. after shot

Gas ____ Cu. Ft.

Dry Hole

Abandoned

Date

8/2 191 4 Tyler Scout


Form 26—M Books of 100 Sheets Each—4-15-18

Map No. ____ Sec. 22 Twp. 23 R. 13

Well No. 1 Lowell McNeil

Casden et al Company

Contractor

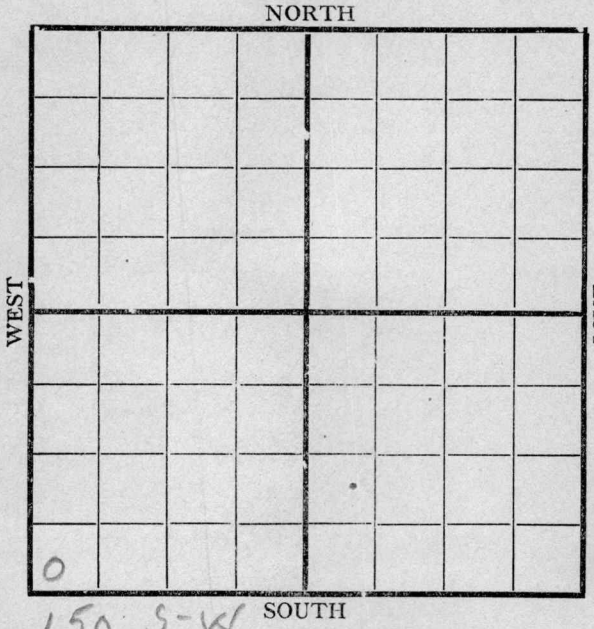

Location ____

Rig up ____

Drilling and Remarks:

No report this week
Last report 1700'

RECORD

Cased ____ in., ____ ft.

Sand ____

Gas ____

Oil ____

Total Depth ____

PRODUCTION

1st 24 hrs. Nat. ____

1st 24 hrs. after shot ____

Gas ____ Cu. Ft.

Dry Hole ____

Abandoned ____

Date

8/9/ 191 9. Gyle Scout


Form 26—1M Books of 100 Sheets Each—4-15-18

Map No. K Sec. 22 Twp. 23 R. 13

Well No. 1 Lovett Tom. C Neil

Cowden et al Company

Contractor

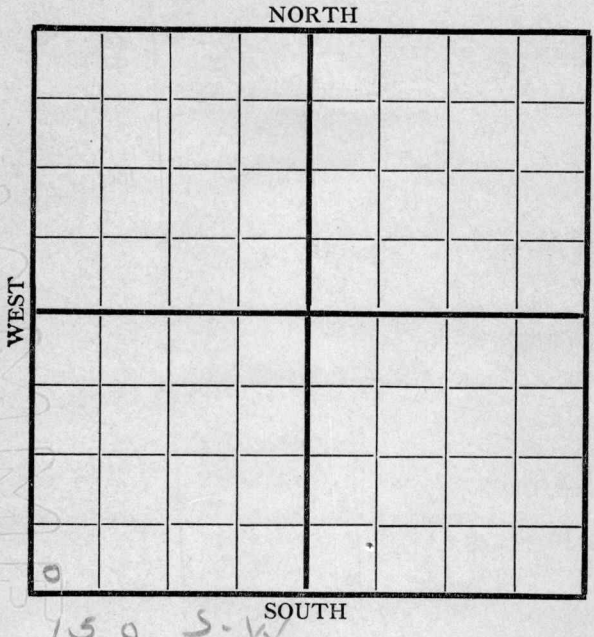

Location

Rig up

Drilling and Remarks:

D. D @ 1735
for fuel

RECORD

Cased in., ft.

Sand

Gas

Oil

Total Depth

PRODUCTION

1st 24 hrs. Nat.

1st 24 hrs. after shot

Gas Cu. Ft.

Dry Hole

Abandoned

Date 8/16/19

Pyle Scout

P O & G Form P-203—6-17—500 Books

Sec. 22 Twp. 23 Rge. 13

Owner Cowden et al

Farm Lovett McNeil Well No. 1

Contractor

Feet from lines, N. E. S. 150 W. 150

Casing used

15½ ft.

12½ ft.

10 ft.


8¼ ft.

6⅝ ft.

5 3-16 ft.

Location

Rig

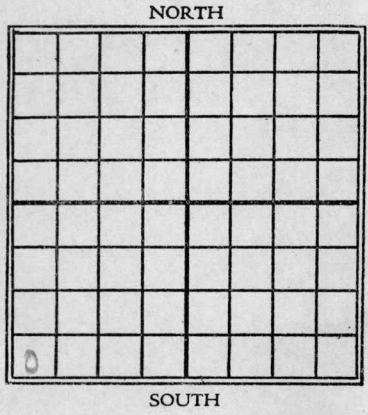

Drilling at ft. Fishing at ft.

Total Depth Completed

1st 24 Hrs. Nat. Producing

1st 24 Hrs. Shot Dry Hole

Gas Cu. ft. Abandoned

Sands — give name and depth. Top Bottom

SI O for fuel

@ 1735'

Date of Report 8/21

Reported by Pyle

Form 26—1M—4-19—Mid-West


Map No. _____ Sec. 22 Twp. 23 R. 13

Well No. 1 Lovett & McNeil

Cooden et al Company

_____ Contractor

SECTION PLAT

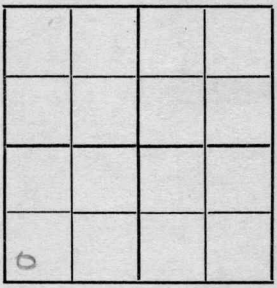

_____ Ft. from N. Line

150 Ft. from S. Line

_____ Ft. from E. Line

150 Ft. from W. Line

Location _____

Rig up _____

Drilling and Remarks:

fishing tool @ 1750'

50 ft oil in hole

RECORD

Cased _____ in., _____ ft.

Sand _____

Gas _____

Oil _____

Total Depth _____

PRODUCTION

1st 24 hrs. Nat. _____

1st 24 hrs. after shot _____

Gas _____ Cu. Ft.

Dry Hole _____

Abandoned _____

Date

8/29 191 9. Pyle Scout

Form 26—1M—4-19—Mid-West


Map No. K Sec. 22 Twp. 23 R. 13

Well No. 1 Lovett & McNeil

Cosden et al Company

Contractor

SECTION PLAT

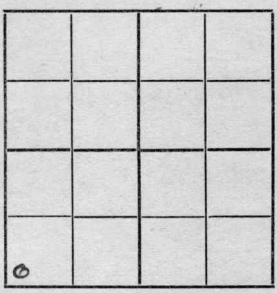

_____ Ft. from N. Line

150 Ft. from S. Line

_____ Ft. from E. Line

150 Ft. from W. Line

Location _____

Rig up _____

Drilling and Remarks:

D, D for water @ 1748 50 fluid in hole tools stuck

RECORD

Cased _____ in., _____ ft.

Sand _____

Gas _____

Oil _____

Total Depth _____

PRODUCTION

1st 24 hrs. Nat. _____

1st 24 hrs. after shot _____

Gas _____ Cu. Ft.

Dry Hole _____

Abandoned _____

Date

9/4 1919

Pyle Scout

Form 26—1M—4-19—Mid-West


Map No. _____ Sec. 22 Twp. 23 R. 13

Well No. 1 Lovett & McNeil

Cozden etal Company

_____ Contractor

SECTION PLAT

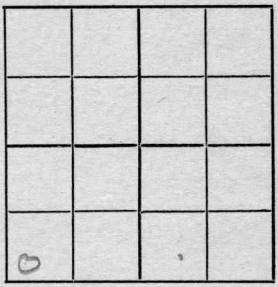

_____ Ft. from N. Line

150 Ft. from S. Line

_____ Ft. from E. Line

150 Ft. from W. Line

Location _____

Rig up _____

Drilling and Remarks:

S.D. 1748'
50' fluid in
tube; Tools
stuck
9/6

RECORD

Cased _____ in., _____ ft.

Sand _____

Gas _____

Oil _____

Total Depth _____

PRODUCTION

1st 24 hrs. Nat. _____

1st 24 hrs. after shot _____

Gas _____ Cu. Ft.

Dry Hole _____

Abandoned _____

Date

9/13 191 9 Office Scout

Form 26—1M—4-19—Mid-West


Map No. _____ Sec. 22 Twp. 23 R. 13

Well No. 1 Loveth & McNeil

Cosden et al Company

_____ Contractor

SECTION PLAT

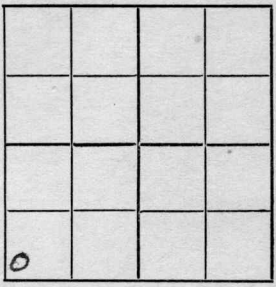

_____ Ft. from N. Line

150 Ft. from S. Line

_____ Ft. from E. Line

150 Ft. from W. Line

Location _____

Rig up _____

Drilling and Remarks:

fishing bit @ 1748'

RECORD

Cased _____ in., _____ ft.

Sand _____

Gas _____

Oil _____

Total Depth _____

PRODUCTION

1st 24 hrs. Nat. _____

1st 24 hrs. after shot _____

Gas _____ Cu. Ft.

Dry Hole _____

Abandoned _____

Date

9/20/1919

Pyle Scout

Form 26—1M—4-19—Mid-West


Map No. K Sec. 22 Twp. 23 R. 13

Well No. 1 Lovett & McNeil

Cosden et al Company

Contractor

SECTION PLAT

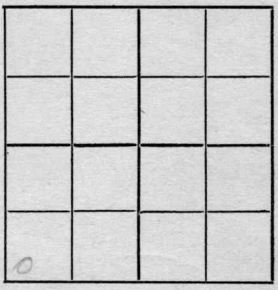

Ft. from N. Line

150 Ft. from S. Line

Ft. from E. Line

150 Ft. from W. Line

Location

Rig up

Drilling and Remarks:

fishing tools @ 1748

RECORD

Cased in., ft.

Sand

Gas

Oil

Total Depth

PRODUCTION

1st 24 hrs. Nat.

1st 24 hrs. after shot

Gas Cu. Ft.

Dry Hole

Abandoned

Date

9/27 1919

Pyle Scout

Form 26—1M—4-19—Mid-West


Map No. K Sec. 22 Twp. 23 R. 13

Well No. 1 Loveth & Mc Neil

Michehoma Oil et al Company

Contractor

SECTION PLAT

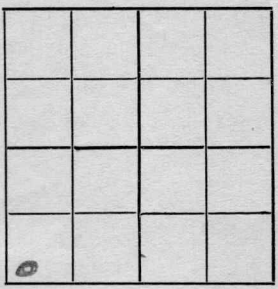

Ft. from N. Line

150 Ft. from S. Line

Ft. from E. Line

150 Ft. from W. Line

CHANGE LESSEE NAME

Location

Rig up

Drilling and Remarks:

RECORD

Cased in., ft.

Sand

Gas

Oil

Total Depth

PRODUCTION

1st 24 hrs. Nat.

1st 24 hrs. after shot

Gas Cu. Ft.

Dry Hole

Abandoned

Date

3/5 1920

Pyle Scout

Form 26—1M—4-19—Mid-West

Map No. KO Sec. 22 Twp. 23 R. 13

Well No. 1 Lovett & McNeil

Michelena Oil Company

Contractor

SECTION PLAT



Ft. from N. Line

150 Ft. from S. Line

Ft. from E. Line

150 Ft. from W. Line

Location

Rig up

Drilling and Remarks:

Pumped off @ 8 bbls for past 6 days.

RECORD

Cased in., ft.

Sand 1748 - 76

Gas

Oil

Total Depth

PRODUCTION

1st 24 hrs. Nat. 8 bbls

1st 24 hrs. after shot

Gas Cu. Ft.

Dry Hole

Abandoned

Date

6/23 1920

Pyle Scout