


Butler

Section 21 Township 27 Range 6E

Well No. #1 Pondexder (*Poindexter*)

Company H. & M. Drlg.

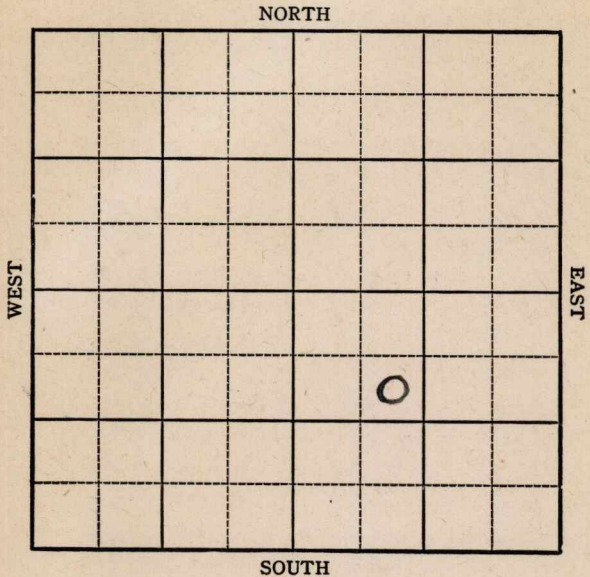

Sec. 21 Twp. 27 R. 6E

Well No. #1 Pondexder Farm
H. & M. Drlg. Company

Miscellaneous


990 Ft. from N. Line

_____ Ft. from S. Line

_____ Ft. from E. Line

990 Ft. from W. Line

Elev. 1313

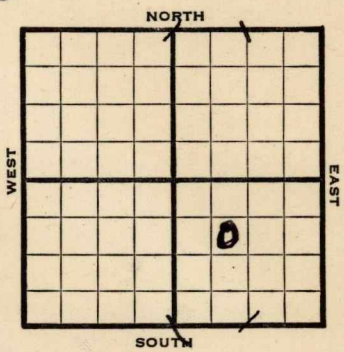

1944

REPORT

- 3/29 Location
- 4/5 Machine
- 4/12 20" @ 25'
- 15" @ 283
- Drlg. 310
- 4/19 Drlg. 990'
- 4/26 12" @ 960-1300 SD
- 5/3 Lans 1703
- Drlg. 1775'
- 5/10 Drlg. 1883
- 10" @ 1878'
- 5/17 **Kansas City 2040**
- Drlg. 2610
- 5/24 **Miss. 2685**
- Drlg. 2885
- 5/31 **B. Miss. 2955**
- TD 3007
- Run 7" .
- 6/7 **Viola 2995-97 TD**
- Run 7"
- 6/21 **Viola 3001**

OVER

1944

6/21

Viola 3001

7" @ 3001

T.D. 3003

2000 Acid

T.D. 3003

Pump 200 Pot

39.0 Gr.

Corrected

COMPLETED

KANSAS
Map No. // Sec. 21 Twp. 27 R. 6E

Well No. 1 Pondexder

H. & M. Drlg. Company

FIRST REPORT Contractor

SE NW SE


SECTION PLAT

990 Ft. from N. Line

_____ Ft. from S. Line

_____ Ft. from E. Line

990 Ft. from W. Line

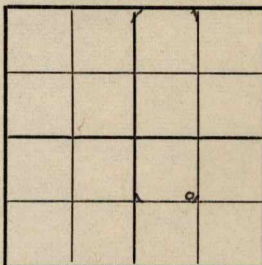

Miscellaneous

Location X

Rig up _____

Drilling and Remarks:

RECORD

Cased _____ in., _____ ft.

Sand _____

Gas _____

Oil _____

Total Depth _____

PRODUCTION

1st 24 hrs. Nat. _____

1st 24 hrs. after shot _____

Gas _____ Cu. Ft.

Dry Hole _____

Abandoned _____

Date

MAR 29 1944 19

S. J. LEWIS Scout

KANSAS

Pool Name: Miscellaneous

Map No. 11 Sec. 21 Twp. 27 R. 6E

Well No. 1 Pondexder


H. & M. Drlg. Company

COMPLETED Contractor

SE NW SE

SECTION PLAT

990 Ft. from N. Line
 _____ Ft. from S. Line
 _____ Ft. from E. Line
990 Ft. from W. Line

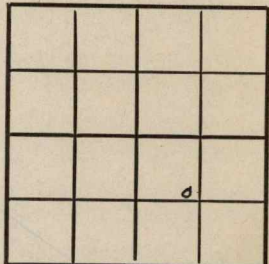

Butler County

RECORD

Location _____

Cased _____ in., _____ ft.

Rig up _____

Sand _____

Drilling and Remarks:

Gas _____

Viola 3001
7" @ 3001
2000 cad
NT 3003 corrected
Pump 200 BY
39° SW

Oil _____

Total Depth 3003

PRODUCTION

1st 24 hrs. Nat. _____

1st 24 hrs. after shot _____

Gas _____ Cu. Ft.

Dry Hole _____

Abandoned _____

Date

JUN 21 1944 19

S. J. LEWIS Scout