


Section 21 Township 27 Range 6E

Well No. #3 Poindexter

Company H & M Drilling

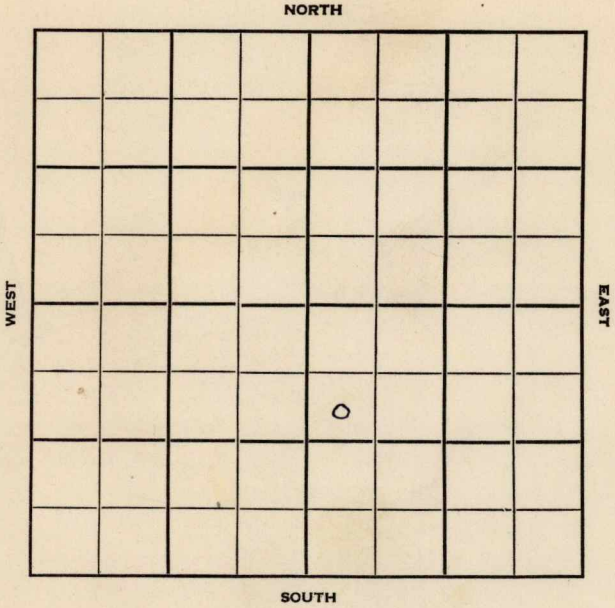

Butler

KANSAS

Sec. 21 Twp. 27 R. 6E ✓

Well No. #3 Poindexter Farm

H & M Drlg. Company

Contractor

Leon Pool


990' Ft. from N. Line

_____ Ft. from S. Line

_____ Ft. from E. Line

330' Ft. from W. Line

SW NW SE

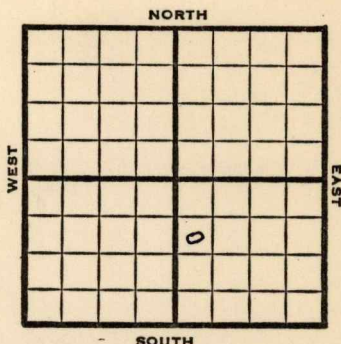

1951

Elev. 1314'

REPORT

9/12

MIR

10/31

Spud 9-12-51

Oil Well TD 3001

8" @ 65'

Viola 2997 5" @ 2990

TD 3001

2200 A Comp. 30 bopd

COMPLETED

County **Butler** State **Kansas**Sec. **21** (Blk. Twp.) **27** (Sur. Rge.) **6E** Map No.Operator **H & M Drilling**Well No. **3** Farm **Poindexter**Elev. Location **SW NW SE**

FIRST REPORT

0

990 Ft. From **N** Line **SE**330 Ft. From **W** Line Quarter1st. Report **SEP 12 1951**

Completion

Remarks

Spudding Date

Drlg. Data

Leon - pool**MIR**

J. E. TYRA

