

Map No. _____ Sec. 29 Twp. 23 R. 13

Well No. 2 Lovett. O. McNeil Farm


~~Shannon~~ Company
Sandrick

_____ Ft. from N. Line

200 Ft. from S. Line

_____ Ft. from E. Line

1120 Ft. from W. Line

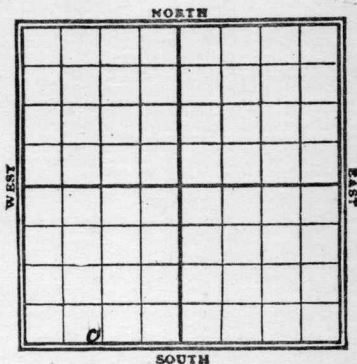

Date
1920
9/23
11/3
1921
1/21

REPORT

Run up
SD 600'
1701-22-
shot 40 gts / 10 lbs
May drill deeper

COMPLETED

Kansas

Map No. No map Sec. 22 Twp. 23 R. 13

Well No. 2 Lovett + McNeil
Michihoma Oil Company

or Sandich - KGS Contractor

SECTION PLAT

FIRST REPORT

----- Ft. from N. Line
200 Ft. from S. Line
----- Ft. from E. Line
1120 Ft. from W. Line

Location -----

Rig up -----

Drilling and Remarks:

RECORD

Cased ----- in., ----- ft

Sand -----

Gas -----

Oil -----

Total Depth -----

PRODUCTION

1st 24 hrs. Nat. -----

1st 24 hrs. after shot -----

Gas ----- Cu. Ft.

Dry Hole -----

Abandoned -----

Date

9/23 1920

Pyle

Scout

Map No. K17 Sec. 22 Twp. 23 R. 13

Well No. 2 Lovett + M^c Neil
The Landick Oil Company

----- Contractor

SECTION PLAT

----- Ft. from N. Line
 ----- Ft. from S. Line
 ----- Ft. from E. Line
 ----- Ft. from W. Line

COMPLETED

Location -----

Rig up -----

Drilling and Remarks:

*Shot 40 qts
 May drill
 deeper.*

RECORD

Cased ----- in., ----- ft.
 Sand 1701-22
 Gas -----
 Oil -----
 Total Depth -----

PRODUCTION

1st 24 hrs. Nat. -----
 1st 24 hrs. after shot 10 B.
 Gas ----- Cu. Ft.
 Dry Hole -----
 Abandoned -----

Date

1/21 19121

Pyle

----- Scout